TOWN OF ARLINGTON, VERMONT CONTRACT DRAWINGS FOR WATER SYSTEM IMPROVEMENTS CONTRACT No. 1

DWSRF LOAN #RF3-333 FEBRUARY, 2016



DRAWING NO.

TITLE SHEET AND INDEX OF DRAWINGS TITLE SHEET AND INDEX OF DRAWINGS
GENERAL NOTES AND LEGEND
DRAWING LOCATION PLAN
ROUTE 7A PLAN AND PROFILE STA 0+00 TO 9+30
ROUTE 7A PLAN AND PROFILE STA 0+00 TO 10+00
ROUTE 7A PLAN AND PROFILE STA 10+00 TO 20+01
ROUTE 7A PLAN AND PROFILE STA 0+00 TO 20+01
ROUTE 7A PLAN AND PROFILE STA 0+00 TO 20+01
ROUTE 7A PLAN AND PROFILE STA 0+00 TO 8+32
EAST ARLINGTON ROAD PLAN AND PROFILE STA 0+00 TO 4+30
ROUTE 313 PLAN AND PROFILE STA 0+00 TO 3+67
MUNN TERRACE PLAN AND PROFILE STA 0+00 TO 5+74
CHISCIVILIE ROAD PLAN AND PROFILE STA 0+00 TO 5+74 CHISCLVILLE ROAD PLAN AND PROFILE STA 0+00 TO 5+00 CHISCLVILLE ROAD PLAN AND PROFILE STA 5+00 TO 9+93 (DEP POND ROAD ROAD PLAN AND PROFILE STA 5+00 TO 4+27 WARM BROOK ROAD PLAN AND PROFILE STA 0+00 TO 1+77 WATER DETAILS WATER AND ROADWAY DETAILS ROADWAY DETAILS EROSION CONTROL DETAILS AND NOTES

ISSUED FOR 60% REVIEW NOT FOR CONSTRUCTION

reserved. No duplication or distribution by anyone other than Blueprints Etc., or those authorized in writing by A+E to print and distribute these documents, is allowed by law. Violation of this copyright is a finable offense in Vermont and violators will be prosecuted. Copy shops and view rooms are specifically prohibited from making

INDEX OF DRAWINGS

6 Market Place, Suite 2 Essex Jct., VT 05452

> TOWN OF ARLINGTON, VERMONT

WATER SYSTEM IMPROVEMENTS CONTRACT No.

TITLE SHEET AND INDEX OF DRAWINGS

	DESIGNED	PROJECT N
	NAP	1506
	DRAWN	1300
- 1	JEN	DRAWING
	CHECKED	_
ŀ	JJD	1 1
	DATE	1 1
	FEB. 2016	

TOWN SELECTBOARD

KEITH SQUIRES, CHAIR CYNTHIA BROWNING DANIEL HARVEY REGINALD JENNINGS

TIMOTHY WILLIAMS

TOWN CLERK

ROBIN WILCOX

LEGEND

PROJECT LOCATION.

LEGEND

EXISTING

PLAN SIDEWALK-CONCRETE TELEPHONE POLE..... POWER POLE..... SEPTIC SYSTEM S (IP) u

M

9

米

0

Δ

PROFILE

REF == REFUSAL

NLTD = NO LEDGE TO DEPTH

VTILITY	. ^	
	<u> </u>	
SOIL BORING/PROBE	SB-1 REF	P-1 NLTI

PROPOSED

--360

PLAN

WATER LINE	W
STUB]
SILT FENCE	
PERMANENT EASEMENT LIMIT	
TEMPORARY FASEMENT LIMIT	
GATE VALVE	н
FIRE HYDRANT	₽
FLUSHING HYDRANT	*
CURB STOP	θ
REDUCER	>
TRANSITION COUPLING	H
TEST PIT (BY CONTRACTOR)	
PROFILE	
PIPE UNE	
INSULATION OVER PIPE	
	0
	0
FITTING	0
FITTING	()
FITTING	() 0
FITTING. VALVE. HYDRANT. CORPORATION STOP.	
FITTING	

REQUIRED TRAFFIC CONTROL

UNIFORMED TRAFFIC CONTROL SCHEDULE				
LOCATION	DRAWING No.	STATION	DESCRIPTION	HOURS
US ROUTE 7A	3	0+00 TO 9+28	OPEN CUT INSTALLATION AND DIRECTIONAL DRILL	-
US ROUTE 7A	4	0+00 TO 10+00	OPEN CUT INSTALLATION AND DIRECTIONAL DRILL	-
US ROUTE 7A	5	10+00 TO 20+08	OPEN CUT INSTALLATION AND DIRECTIONAL DRILL	
US ROUTE 7A	6	0+00 TO 8+36	OPEN CUT INSTALLATION AND DIRECTIONAL DRILL	-
US ROUTE 7A	9	0+00 TO 8+69	OPEN CUT INSTALLATION AND DIRECTIONAL DRILL	-

- LEST UNIFORMED TRAFFIC CONTROL SHALL BE PROVIDED AT ONE END OF OPERATION DURING CONSTRUCTION AT THE LOCATIONS SPECIFIED IN THE ABOVE SCHEDULE. A FLAG PERSON SHALL BE PROVIDED AT THE OTHER END, LANE CLOSURES SHALL BE IN ACCORDANCE WITH YTRANS STANDARD E-110 MAJOR MAINTENANCE OPERATION LANE CLOSURE. ALL AREAS SHALL BE RESTORED TO NORMAL TWO-WAY TRAFFIC AS SOON AS POSSIBLE, AND AT THE END OF EACH DAY'S
- 2. FOR ALL AREAS AT LEAST ONE—WAY TRAFFIC SHALL BE MAINTAINED AT ALL TIMES. PROVIDE FLAG PERSONS AT BOTH ENDS OF OPERATION AND ESTABLISHED
- 3. REFER TO SECTION 01570 FOR TRAFFIC REGULATION REQUIREMENTS.
- 4. THE COST OF UNIFORMED TRAFFIC CONTROL SHALL BE PAID FOR UNDER BID ITEM E-4. AS APPROPRIATE.
- 5. THE COST FOR CERTIFIED FLAG PERSONS, ALL OTHER MATERIALS, AND SIGNAGE RELATED TO TRAFFIC CONTROL SHALL BE CONSIDERED INCIDENTAL TO THE WATERLINE.

A. THE CONTRACTOR SHALL TAKE ALL NECESSARY PRECAUTIONS FOR THE SAFFTY OF EMPLOYEES ON THE PROJECT AND SHALL COMPLY WITH ALL APPLICABLE PROVISIONS OF FEDERAL, STATE AND LOCAL SAFETY LAWS AND BUILDING CODES TO PREVENT ACCIDENTS OR INJURY. THE CONTRACTOR SHALL ERECT AND PROPERLY MAINTAIN AT ALL TIMES ALL NECESSARY SAFEGUARDS AND BARRICADES FOR THE PROTECTION OF EMPLOYEES ON THE WORK AND SAFETY OF OTHERS EMPLOYED NEAR THE WORK AND THE PUBLIC FURTHER, THE CONTRACTOR SHALL POST DANGER SIGNS AND OTHER WARNING DEVICES TO PROTECT INDMIDUALS FROM BEING INJURED IN THE VICINITY OF THE WORK.

- B. THE CONTRACTOR SHALL COMPLY WITH ALL APPLICABLE V.O.S.H.A. SAFETY REQUIREMENTS THE CONTRACTOR SHALL INSURE ALL WORK PROCEEDS IN ACCORDANCE WITH V.O.S.H.A. REQUIREMENTS FOR SAFETY TRENCHING, EXCAVATION, AND CONFINED SPACE ENTRY
- C. THE CONTRACTOR SHALL PROVIDE ADFOUNTE FOUIPMENT AND FACILITIES AS ARE NECESSARY AND REQUIRED TO PROVIDE EMERGENCY FIRST AID TO ANY PERSON WHO MAY BE INJURED IN THE PROSECUTION OF THE WORK UNDER THIS CONTRACT.
- D. THE CONTRACTOR SHALL PROVIDE AND INSTALL ALL NECESSARY TRAFFIC CONTROL SIGNS AND DEVICES BEFORE COMMENCING WORK ON THE PROJECT IN ACCORDANCE WITH THE MANUAL OF UNIFORM TRAFFIC CONTROL DEVICES.

2. EASEMENTS

1. SAFETY

- A. THE CONTRACTOR SHALL PERFORM ALL WORK WITHIN TEMPORARY CONSTRUCTION FASEMENT JMITS AND/OR RIGHTS-OF-WAY AS SHOWN ON THE PLANS
- B. WHERE NO TEMPORARY CONSTRUCTION EASEMENT IS SHOWN ON CONTRACT DRAWINGS. THE CONTRACTOR SHALL STAY WITHIN THE PERMANENT EASEMENT LIMITS, AND/OR RIGHTS-OF-WAY DURING CONSTRUCTION, AS SHOWN ON THE PLANS.

3. PROTECTION OF WORK

- A. THE CONTRACTOR SHALL ASSUME FULL RESPONSIBILITY FOR THE PROTECTION OF ALL BUILDINGS, STRUCTURES AND UTILITIES (BOTH PUBLIC AND PRIVATE), INCLUDING POWER POLES, SIGNS, UTILITY SERVICES, WATER MAINS, HYDRANTS, SEWERS, FORCE MAINS, STORM DRAINS, BURIED ELECTRICAL OR CONTROL WIRES, GAS LINES, AND TELEPHONE CABLES WHETHER OR NOT THEY ARE SHOWN ON THE CONTRACT DRAWINGS
- B. THE CONTRACTOR SHALL CAREFULLY SUPPORT AND PROTECT ANY UTILITIES, STRUCTURES, PIPE LINES, AND CONDUITS WHICH MAY BE ENCOUNTERED DURING COMPLETION OF THE WORK. ANY DAMAGE RESULTING FROM THE CONTRACTOR'S OPERATIONS SHALL BE REPAIRED BY HIM TO THE SATISFACTION OF THE ENGINEER AT CONTRACTOR'S EXPENSE.

4. MAINTENANCE OF FLOWS

A. THE CONTRACTOR SHALL, AT HIS OWN COST, MAKE PROVISIONS FOR MAINTAINING FLOW THROUGH EXISTING FORCE MANNS, SEWER LINES, WATERLINES, STORM DRAINS, AND WATER COURSES WHICH MUST BE INTERRUPTED DURING THE PROCRESS OF THE WORK. UPON COMPLETION OF THE WORK, ALL TEMPORARY FLOW DIVERSIONS, STRUCTURES, AND PIPING SHALL BE REMOVED FROM THE SITE.

5. BURIED UTILITIES

- UNDERGROUND UTILITY LOCATIONS ARE APPROXIMATE ONLY. THOSE SHOWN ON THE DRAWINGS ARE BASED ON THE BEST AVAILABLE INFORMATION. PRIOR TO CONSTRUCTION, THE CONTRACTOR SHALL MEET WITH THE ENGINEER, OWNER, REPRESENTATIVES OF THE TELEPHONE COMPANT, ELECTRICITY COMPANY, CAS COMPANY, CASLE COMPANY, AND ANY OTHER UTILITY COMPANIES INVOLVED WITH THE CONSTRUCTION OF THIS PROJECT TO COORDINATE THE MARKING, AND TIMING OF DISRUPTIONS OF THE VARIOUS UTILITIES, IF ANY.
- B. THE CONTRACTOR SHALL EXCAVATE TEST PITS AS SHOWN ON THE DRAWINGS OR AS APPROVED BY THE ENGINEER, THESE SHALL BE EXCAVATED TO LOCATE BURIED UTILITIES AND TO DETERMINE SIZE, LOCATIONS AND/OR MATERIALS OF EXISTING UTILITIES. SOME HAND EXCAVATING MAY BE NECESSARY TO PROTECT UTILITIES. TEST PITS SHALL BE EXCAVATED AT LEAST TWO (2) WEEKS PRIOR TO CONSTRUCTION SO THAT DESIGN REVISIONS MAY BE MADE IF REQUIRED. TEST PITS INDICATED ON DRAWINGS OR BY WRITTEN DIRECTION FROM THE ENGINEER WILL BE PAID FOR UNDER BID ITEM FOR MISC., EXTRA, AND BELOW GRADE
- C. EXISTING UTILITIES SHALL BE PROTECTED OR REMOVAL AND REPLACEMENT SHALL BE COORDINATED WITH THE APPROPRIATE COMPANY. THE CONTRACTOR IS RESPONSIBLE FOR ALL DAMAGE TO EXISTING UTILITIES AND SHALL BE RESPONSIBLE FOR REPAIR OF ANY SUCH DAMAGE AS QUICKLY AS POSSIBLE AT HIS OWN EXPENSE. ALL UTILITIES WHICH MAY BE BROKEN OR DAMAGED SHALL BE REPAIRED TO AS GOOD OR BETTER CONDITION AND RECONNECTED FOR SERVICE. SUBMIT ALL REPAIR METHODS TO THE ENGINEER FOR APPROVAL NO REPAIR SHALL BE BACKFILLED PRIOR TO INSPECTION BY THE ENGINEER IN THE FIELD. CONTRACTOR SHALL TAKE MEASUREMENTS TO DOCUMENT WHERE ALL SERVICE REPAIRS ARE MADE RECORDS SHALL BE MADE AVAILABLE TO THE ENGINEER AND OWNER VEY AND MADE, RECORDS SPACE BE MADE ANALOBE. TO THE ENGINEER AND UNDON REQUEST AND PRIOR TO THE END OF CONSTRUCTION, THE CONTRACTOR SHALL MAINTAIN A SUPPLY OF REPAIR MATERIALS AND PIPE ON THE JOB SITE AT ALL TIMES IN ORDER TO MINIMIZE THE INCONVENIENCE CAUSED BY SUCH DAMAGE.

6. CONSTRUCTION

- A. THE CONTRACTOR SHALL USE ONLY DESIGNATED BENCH MARKS FOR REFERENCE ELEVATIONS.
- B. THE CONTRACTOR SHALL BE RESPONSIBLE FOR HOLDING UTILITY POLES AS NECESSARY. THE COST OF UTILITY POLE HOLDING SHALL BE INCIDENTAL TO THE PIPE. ALL WORK SHALL BE IN CONFORMANCE WITH UTILITY COMPANY REQUIREMENTS
- C. SUBSURFACE EXPLORATION LOGS ARE BOUND IN THE SPECIFICATIONS.
- D. THE CONTRACTOR SHALL INSTALL A MECHANICAL PLUG IN THE END OF ALL PIPE WORK AT THE COMPLETION OF EACH WORK DAY TO SEAL IT FROM WATER AND SOIL
- E. EXISTING WATER SERVICES SHALL BE MAINTAINED DURING CONSTRUCTION, THE NEW SYSTEM SHALL BE TESTED, INSPECTED, CHLORINATED AND APPROVED PRIOR TO TRANSFERRING SERVICE TO NEW SYSTEM, NO WATER SHALL BE ALLOWED IN THE NEW SYSTEM UNTIL SERVICE TO NEIT STEEM. NO THIRTER STREET BE ALLOYED IN THE RENT STEEM ONTICE
 APPROVED BY THE OWNER AND ENGINEER, AND THE CONDITIONS IN THE AGENCY OF
 NATURAL RESOURCES, DRINKING WATER AND GROUNDWATER PROTECTION DMISION
 CONSTRUCTION PERMIT ARE COMPLETE.
- F. ADDITIONAL BENDS, AS NECESSARY, SHALL BE PROVIDED BY THE CONTRACTOR AT NO ADDITIONAL COST. PROVIDE A MAXIMUM OF 45' BENDS FOR FORCEMAINS. NO 90' BENDS
- G. ALL FITTINGS AND JOINTS ON WATERMAINS SHALL BE MECHANICAL JOINT, PER SPECIFICATIONS. ALL MECHANICAL JOINT FITTINGS SHALL BE PROVIDED WITH RETAINER

GENERAL CONSTRUCTION NOTES

CONSTRUCTION (CONT.)

- H, CONTRACTOR SHALL DOCUMENT THE LOCATIONS OF EXISTING SEWER SERVICES AS THEY ENCOUNTER THEM DURING CONSTRUCTION. WATER SERVICES SHALL BE INSTALLED WITH AT LEAST 10 FEET OF HORIZONTAL AND 18" OF VERTICAL SEPARATION FROM SEWER SERVICES
- I. ALL MAIN LINE GATE VALVES SHALL OPEN-IN DIRECTION AS REQUIRED BY THE OWNER.
- J. THRUST BLOCKS SHALL BE PROVIDED FOR ALL WATERMAIN BENDS AND FITTINGS AND ARE INCIDENTAL TO THE UNIT PRICE OF THE PIPE.
- K. ANY EXISTING WATER SERVICES THAT MAY INTERFERE WITH THE NEW WATER MAIN SHALL NOT BE RELOCATED AT LESS THAN THEIR EXISTING COVER, CONTRACTOR SHALL LOWER THE NEW
- ACCORDANCE WITH CONTRACT DOCUMENTS, EROSION CONTROLS SHALL BE IN PLACE DOWNSTREAM OF THE AREA OF CONSTRUCTION PRIOR THE START OF ANY EARTH DISTURBANCE, ALL DISTURBED AREAS ARE TO BE IMMEDIATELY STABILIZED

WATER MAIN AND ALLOW ADEQUATE CLEARANCE.

- M. THE CONTRACTOR SHALL RESTORE ANY DISTURBED AREA WITHIN THREE (3) WORKING DAYS OF INITIAL DISTURBANCE, ALL RESTORATION SHALL BE AS GOOD OR BETTER THAN ORIGINAL CONDITION AND SHALL MEET THE REQUIREMENTS SET FORTH IN THE EROSION PREVENTION AND SEDIMENT CONTROL PLAN BASIS OF DESIGN.
- N. REMOVAL OF EXISTING VALVE BOXES SHALL BE CONSIDERED INCIDENTAL TO THE PIPE.
- O. ALL NEW CORPORATIONS, HOUSE SERVICES, AND CURB STOPS SHALL BE 3/4" CTS UNLESS
- P. TEMPORARY WATER IS REQUIRED ON ROUTE 313. THE CONTRACTOR IS REQUIRED TO SUBMIT A DETAILED TEMPORARY WATER PLAN (AS A SHOP DRAWING) AT THE PRE-CONSTRUCTION MEETING, REFER TO THE SPECIAL CONDITIONS IN THE SPECIFICATIONS FOR ADDITIONAL
- Q. THE CONTRACTOR WILL BE REQUIRED TO BECOME CO-PERMITTEE ON THE VIRANS 1111 PERMIT. THE CONTRACTOR IS REQUIRED TO PROVIDE THE NECESSARY LEVEL OF TRAFFIC CONTROL AND SIGN PACKAGE FOR WORK WITIN THE VTRANS RIGHT-OF-WAY (ROW). THE CONTRACTOR SHALL SUBMIT A TRAFFIC CONTROL PLAN A MINIMUM OF TWO (2) WEEKS PRIOR TO CONSTRUCTION WITHIN THE VTRANS ROW AS A FORMAL SHOP DRAWING SUBMITTAL FOR REVIEW BY THE ENGINEER AND VIRANS, PROPOSED TRAFFIC CONTROL PACKAGE MUST BE IN ACCORDANCE WITH THE MOST CURRENT EDITION OF THE MANUAL UNIFORM TRAFFIC CONTROL DEVICES (MUTCO).

SITEWORK

- A. THE CONTRACTOR IS RESPONSIBLE FOR RECORDING PRECONSTRUCTION CONDITIONS BY USE OF PHOTOGRAPHS, VIDEO TAPES, AND OTHER METHODS. EXISTING FENCES, GUARDRALS, SIGNS, CATCH BASINS, CULVERTS, HEADWALLS, ETC. REMOVED BY THE CONTRACTOR SHALL BE REPLACED TO AT LEAST THEIR ORIGINAL CONDITION, THE COST OF THIS PRECONSTRUCTION DOCUMENTATION AND RECONSTRUCTION SHALL BE PAID FOR UNDER THE UNIT PRICE BID ITEM FOR PIPE WORK.
- B. ALL EXCESS MATERIAL SHALL BE DISPOSED OF OFF-SITE UNLESS OTHERWISE APPROVED BY THE OWNER, A COPY OF A WRITTEN AGREEMENT BETWEEN THE CONTRACTOR AND THE SITE OWNER SHALL BE SUBMITTED TO THE ENGINEER BEFORE ANY MATERIAL IS DEPOSITED ON ANY SITE, DISPOSAL OF EXCESS MATERIAL OFF-SITE SHALL BE PERFORMED IN ACCORDANCE WITH SOLID WASTE MANAGEMENT DIMSION REGULATIONS AND SHALL INCLUDE OBTAINING ANY
- C. CONTRACTOR IS RESPONSIBLE FOR RESTORING GRAVEL SHOULDERS, PAVED SHOULDERS, ROADWAY SURFACES, DRIVEWAYS, AND CULVERTS TO THE SAME OR BETTER CONDITION AT PROJECT COMPLETION. THE COST OF RESTORATION SHALL BE INCLUDED IN THE APPROPRIATE UNIT PRICE BID ITEM.
- D. SOME MAILBOXES AND SIGNS ARE NOT SHOWN ALONG PROJECT ROUTE FOR REASONS OF CLARITY. THE CONTRACTOR SHALL RESET ALL MAILBOXES AND SIGNS AS SOON AS POSSIBLE, AS CONSTRUCTION PERMITS AND/OR AS DIRECTED BY THE ENGINEER.
- E. TREES LOCATED WITHIN THE TEMPORARY CONSTRUCTION EASEMENT LIMITS SHALL NOT BE TRIMMED, DAMAGED, OR DESTROYED WITHOUT WRITTEN PERMISSION FROM THE PROPERTY OWNER ON A LOCATION BY LOCATION BASIS, DOCUMENTATION MUST BE FURNISHED TO THE ENGINEER PRIOR TO PERFORMING THE WORK.

RECORD DOCUMENTS

- A. ALL BURIED UTILITIES ENCOUNTERED SHALL BE DOCUMENTED WITH DEPTH AND THREE (3) ties and shown by the contractor on record drawings.
- B. ALL NEW SEWER LINES, FORCEMAINS, AND APPURTENACES SHALL BE DOCUMENTED WITH THREE (3) DISTANCE TIES AND DEPTH OF BURY, AND SHOWN BY THE CONTRACTOR ON RECORD DRAWNOS. THIS INFORMATION SHALL BE KEPT CURRENT AND SHALL BE PROVIDED TO THE ENGINEER IMMEDIATELY UPON REQUEST.

9. DIGSAFE

CONTRACTOR SHALL NOTIFY DIG SAFE TWO (2) WEEKS PRIOR TO ANY ANTICIPATED EXCAVATIONS, CONTRACTOR SHALL NOT EXCAVATE IN ANY AREAS UNTIL DIG SAFE HAS BEEN TO THE SITE AND HAS MARKED UTILITIES. (DIG SAFE: 1-888-344-7233)

- A. TOPOGRAPHIC SURVEY DATUM IS BASED ON THE NATIONAL GEODETIC SURVEY USING NAD 83 (1996) HORIZONTAL DATUM AND NAVO 88 VERTICAL DATUM.
- B. PROPERTY AND RIGHT OF WAY (ROW) LINES SHOWN ON THESE DRAWINGS WERE OBTAINED FROM VERMONT CENTER FOR GEOGRAPHIC INFORMATION (VCG), THEY SHOW AN APPROXIMATION OF PROPERTY AND ROW LINES AS THEY RELATE TO THE PROJECT DETAILS BASED ON THE SOURCE REFERENCE INFORMATION. A+E DOES NOT WARRANT THE ACCURACY OF THIS INFORMATION. THESE DRAWINGS SHALL NOT BE CONSTRUED AS A PROPERTY PLAT AND DO NOT DEFINE LEGAL RIGHTS OR MEET LEGAL REQUIREMENTS FOR A LAND SURVEY AS DESCRIBED IN 26 V.S.A. 2502(4).

Aldrich + Elliott

6 Market Place, Suite 2 Essex Jct., VT 05452

> P: 802.879.7733 AEengineers.com


L	 _	_	_	 	 	
CHECKED						
DESCRIPTION						
DATE						
No.						

TOWN OF ARLINGTON, VERMONT

WATER SYSTEM **IMPROVEMENTS** CONTRACT No.

> GENERAL NOTES AND LEGEND

DESIGNED	PROJECT NO.
NAP	15067
DRAWN	10007
JEN	DRAWING
CHECKED	4
JJD	
DATE	
FEB. 2016	

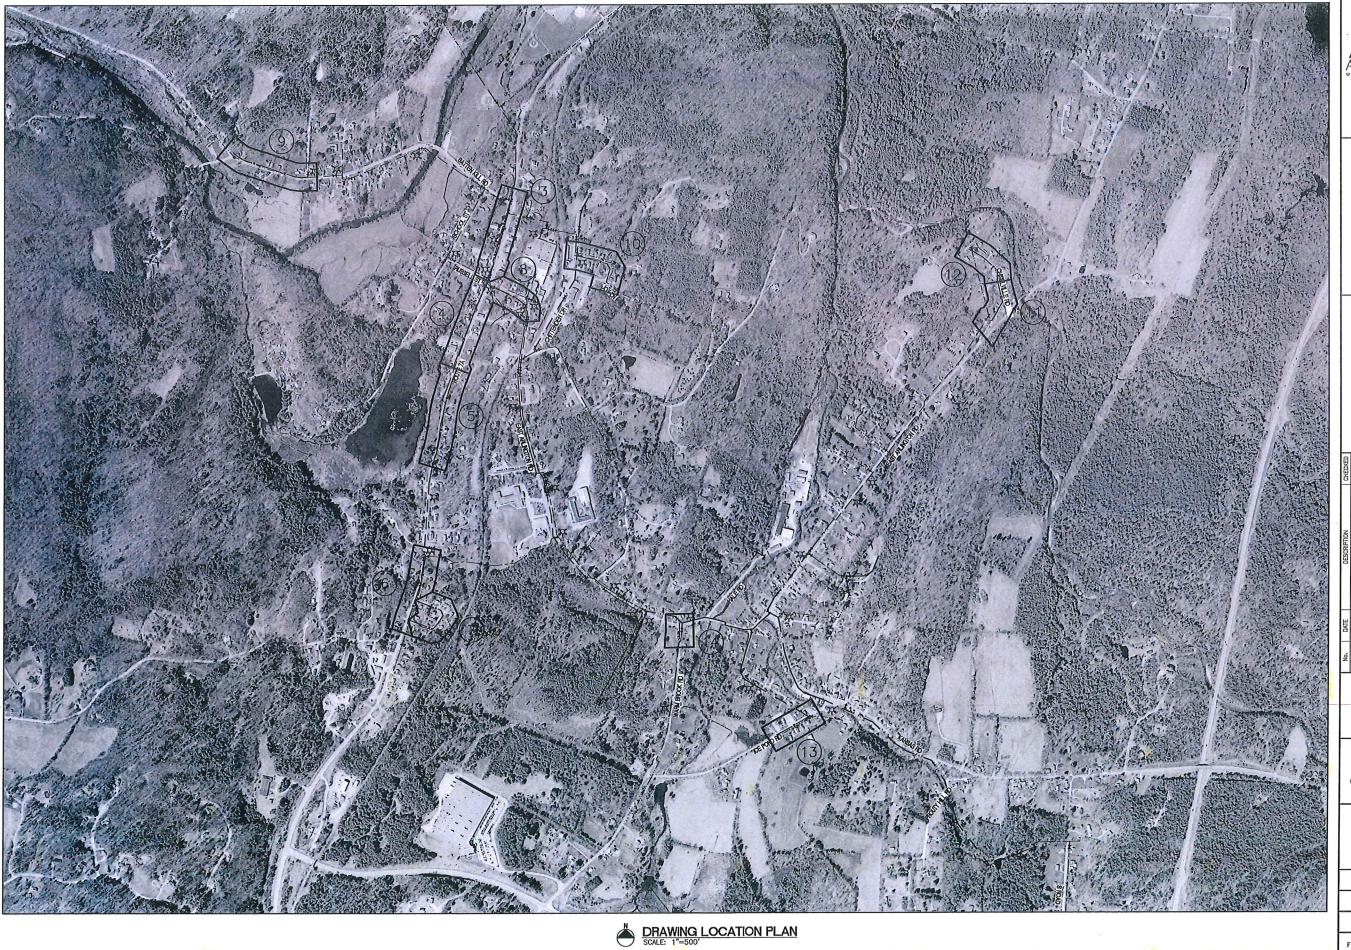

6 Market Place, Suite 2 Essex Jct., VT 05452

P: 802.879.7733 AEengineers.com

WATER SYSTEM IMPROVEMENTS CONTRACT No. 1

TOWN OF ARLINGTON, VERMONT


DRAWING LOCATION PLAN


DESIGNED NAP 15067 DRAWN JEN CHECKED


JJD

DATE
FEB. 2016


2

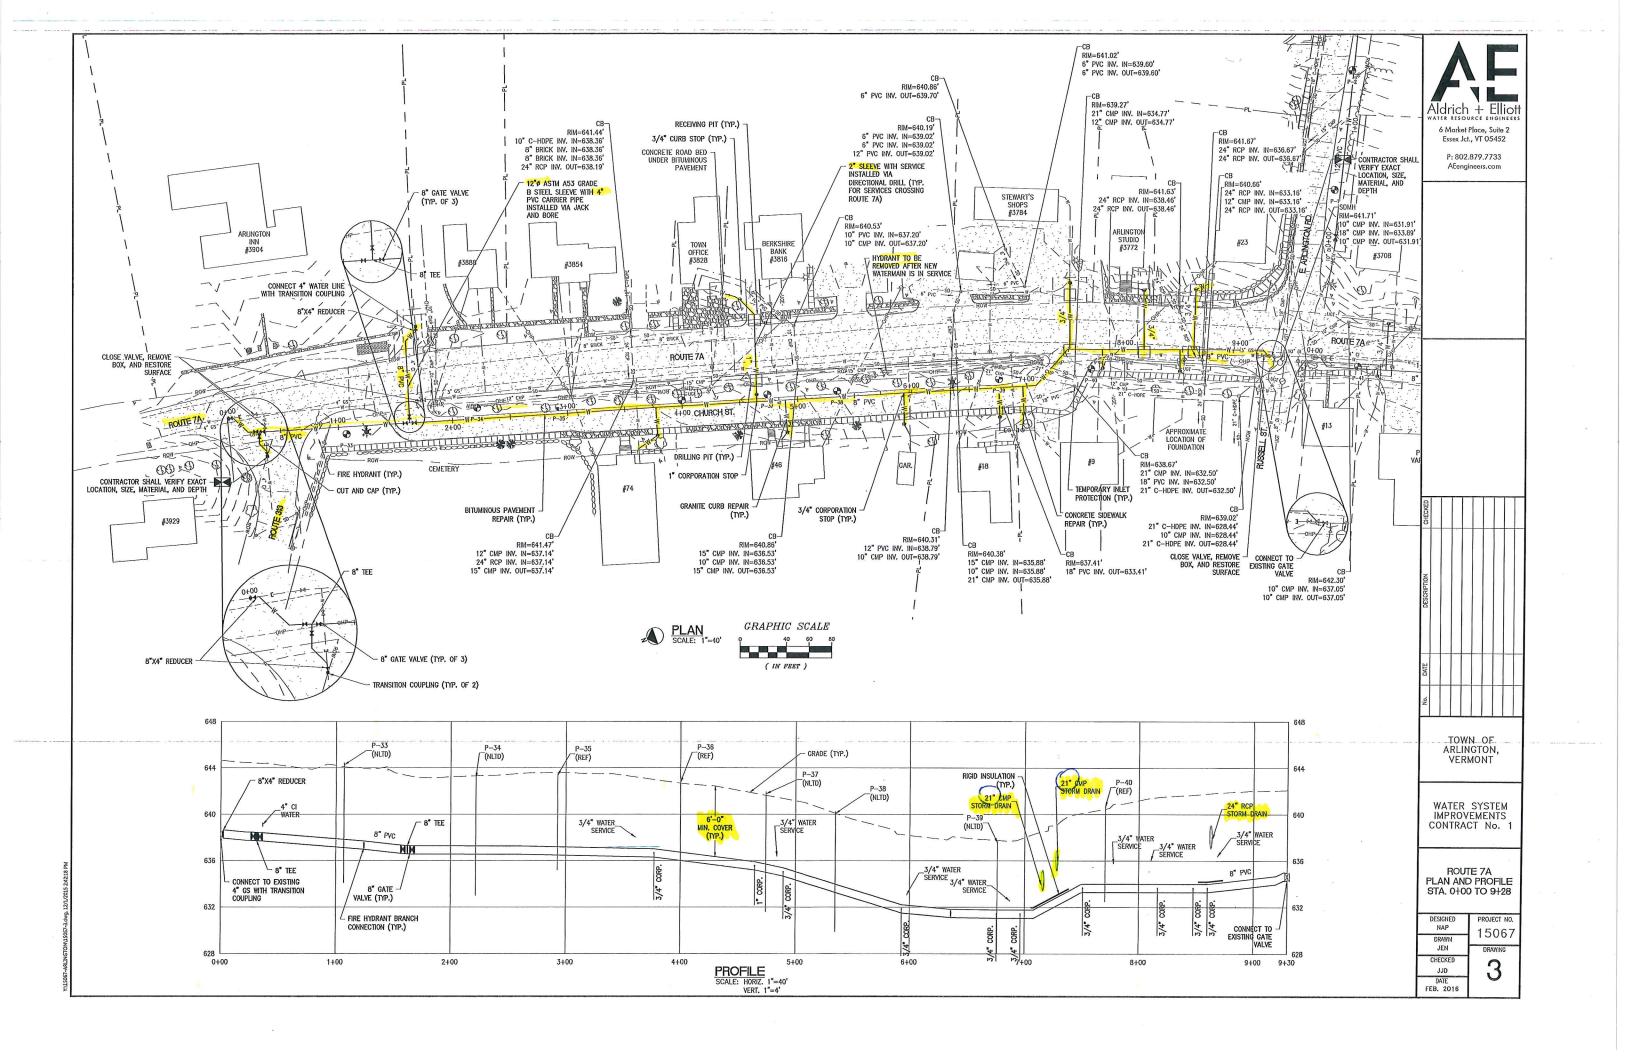


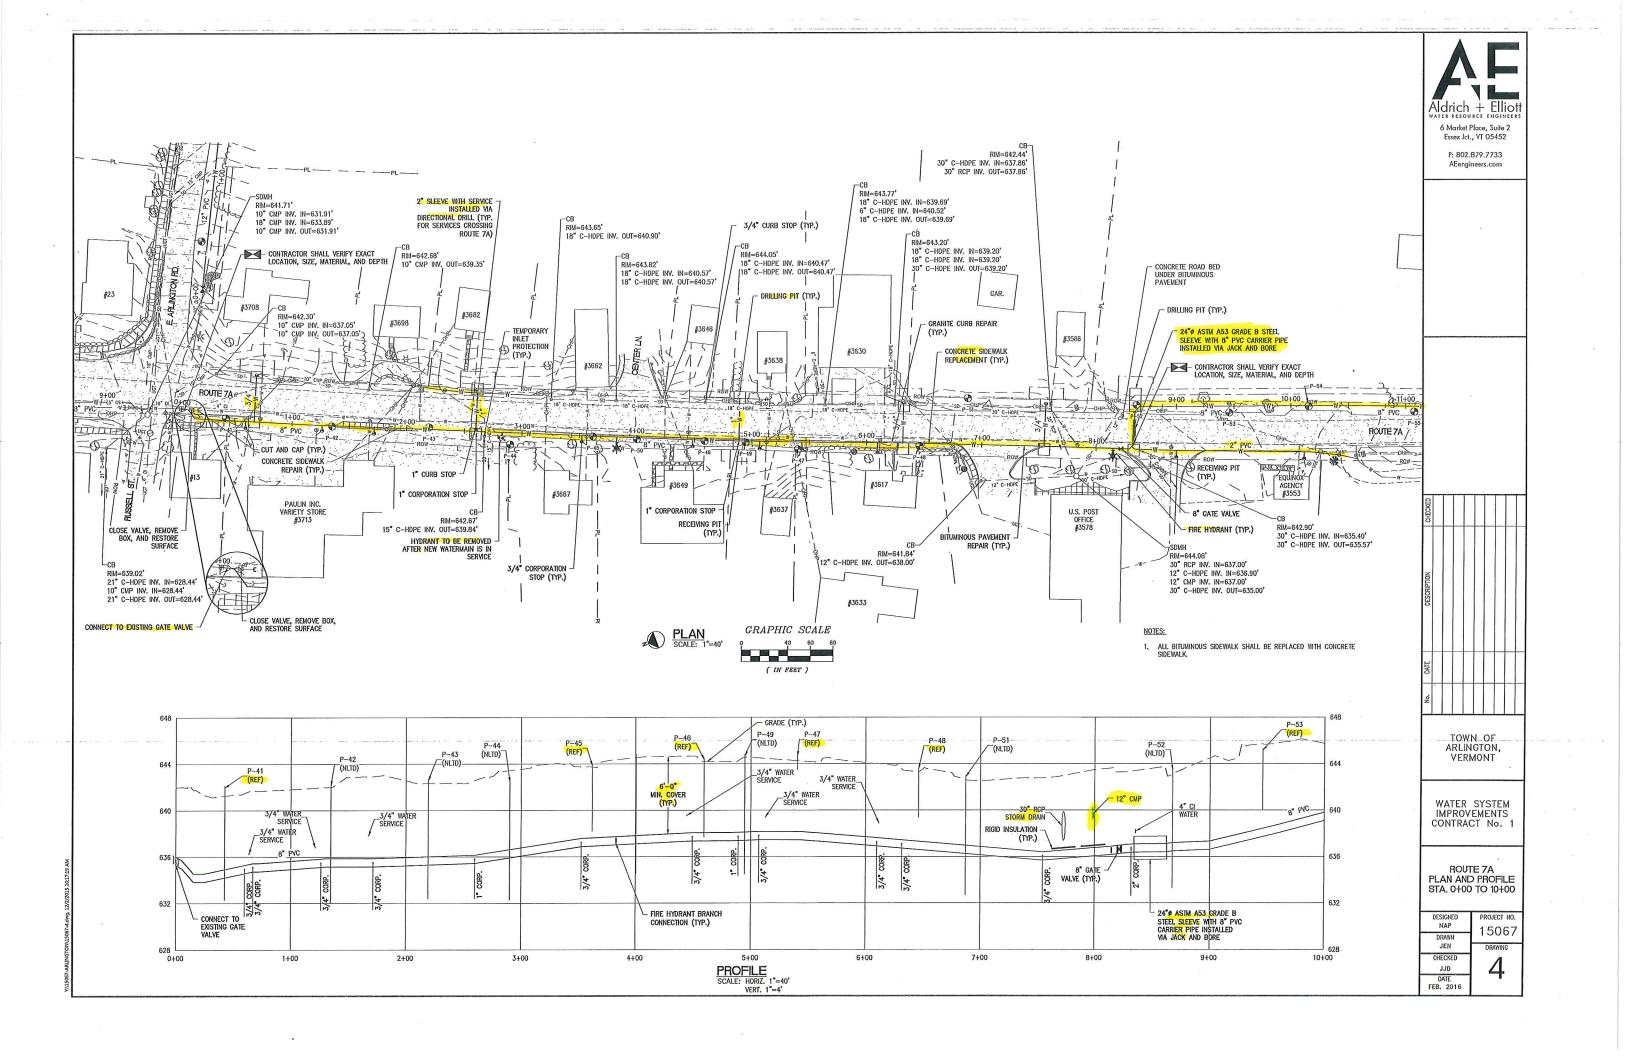


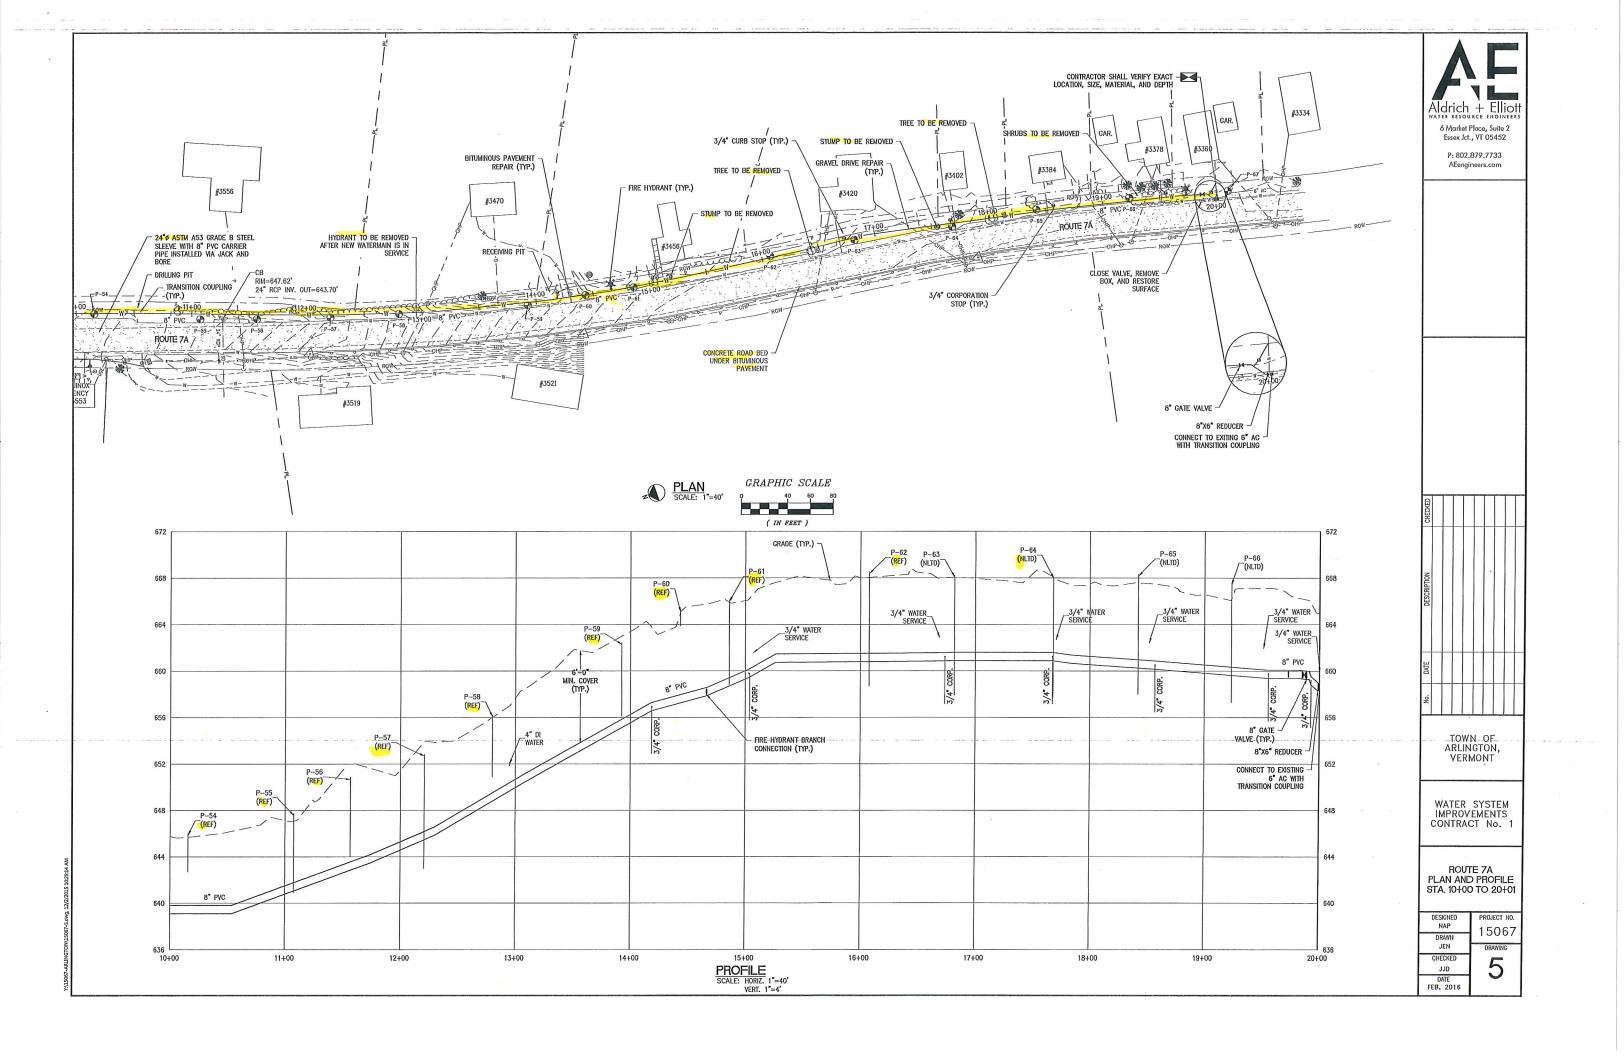





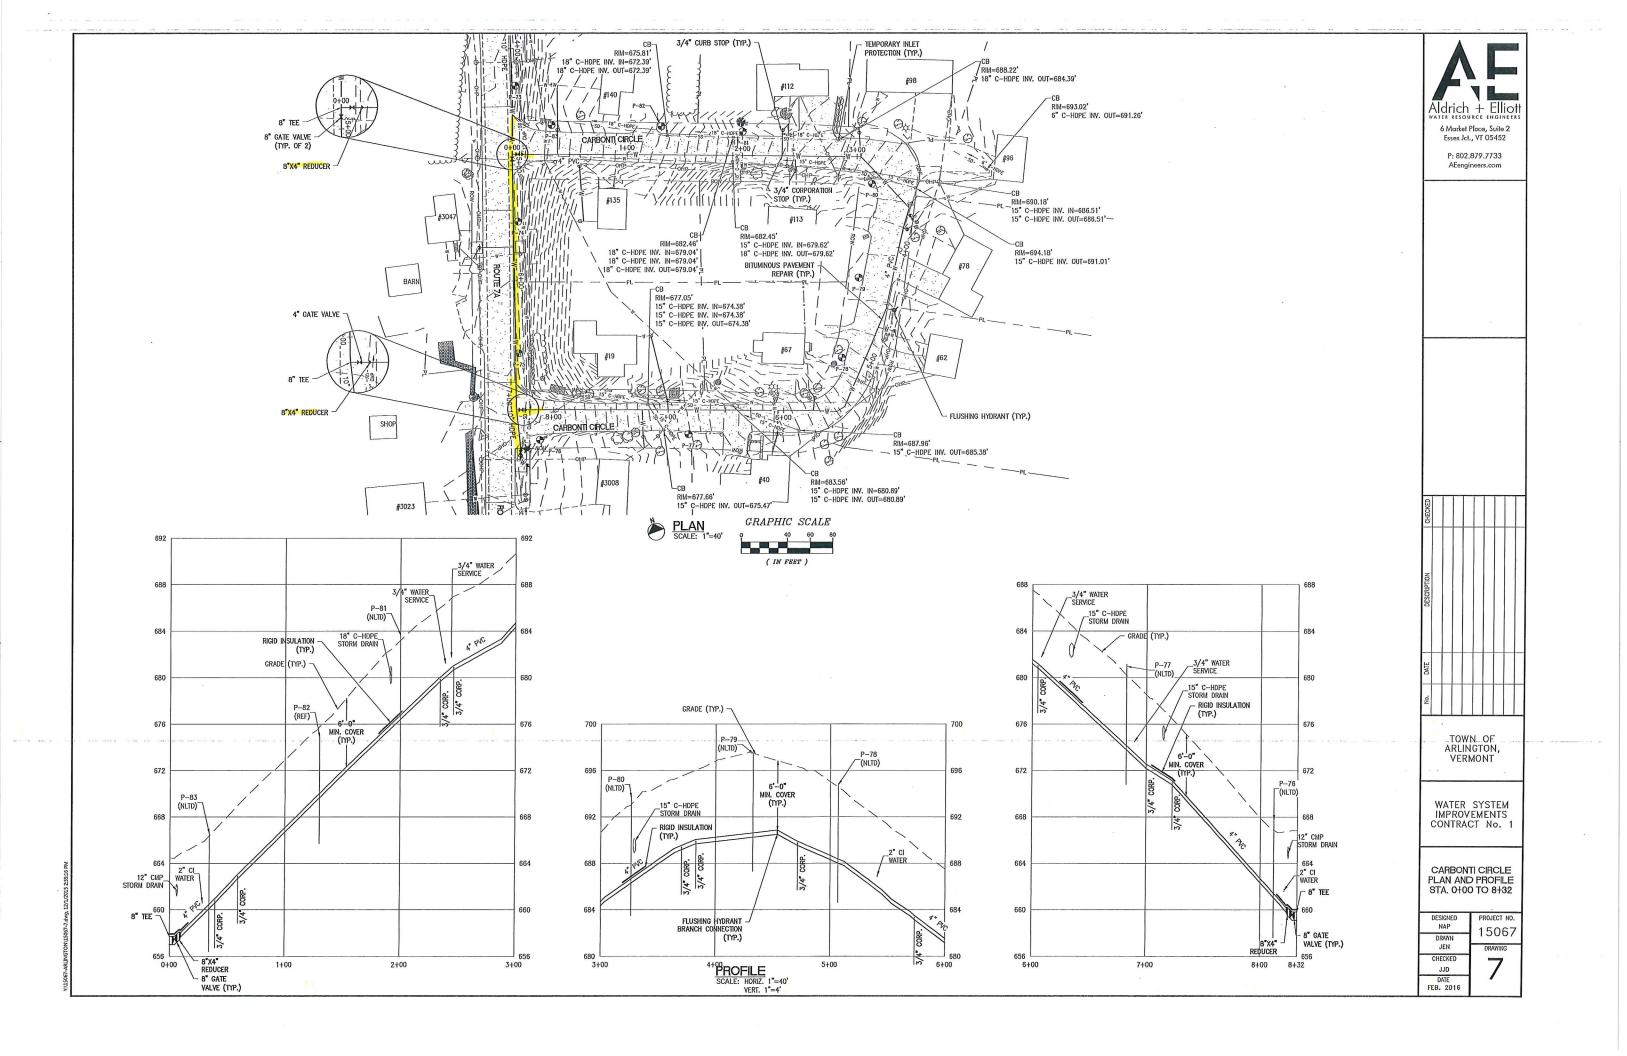


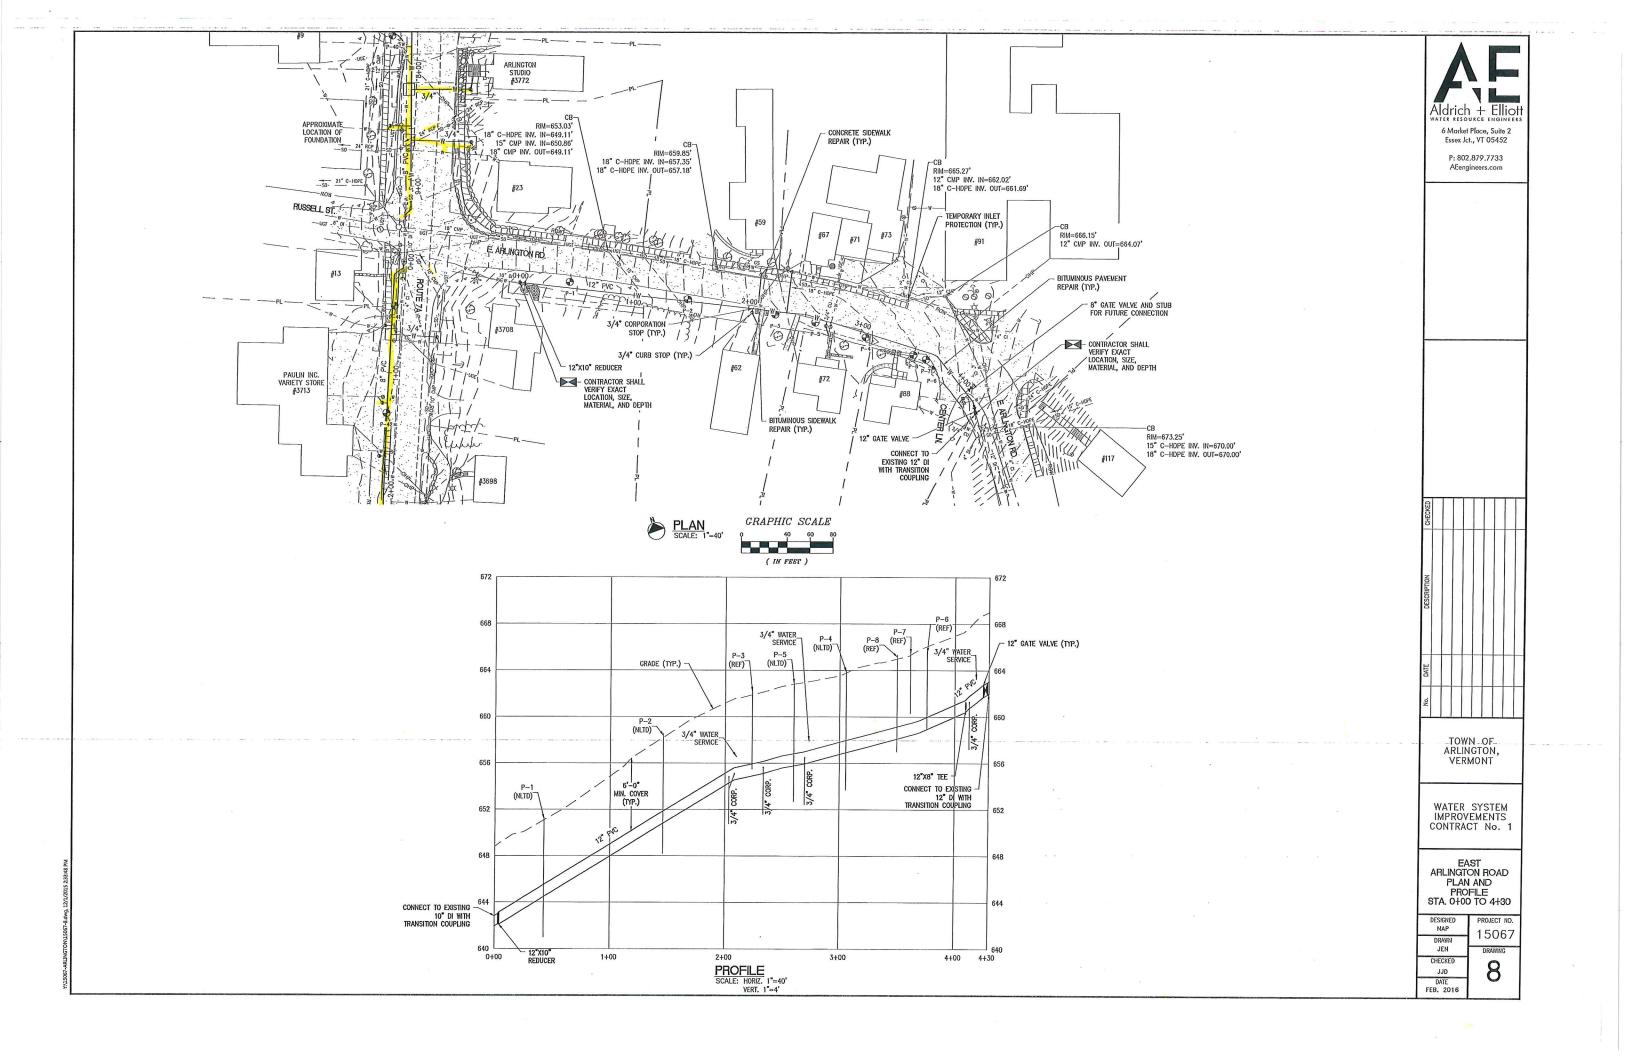


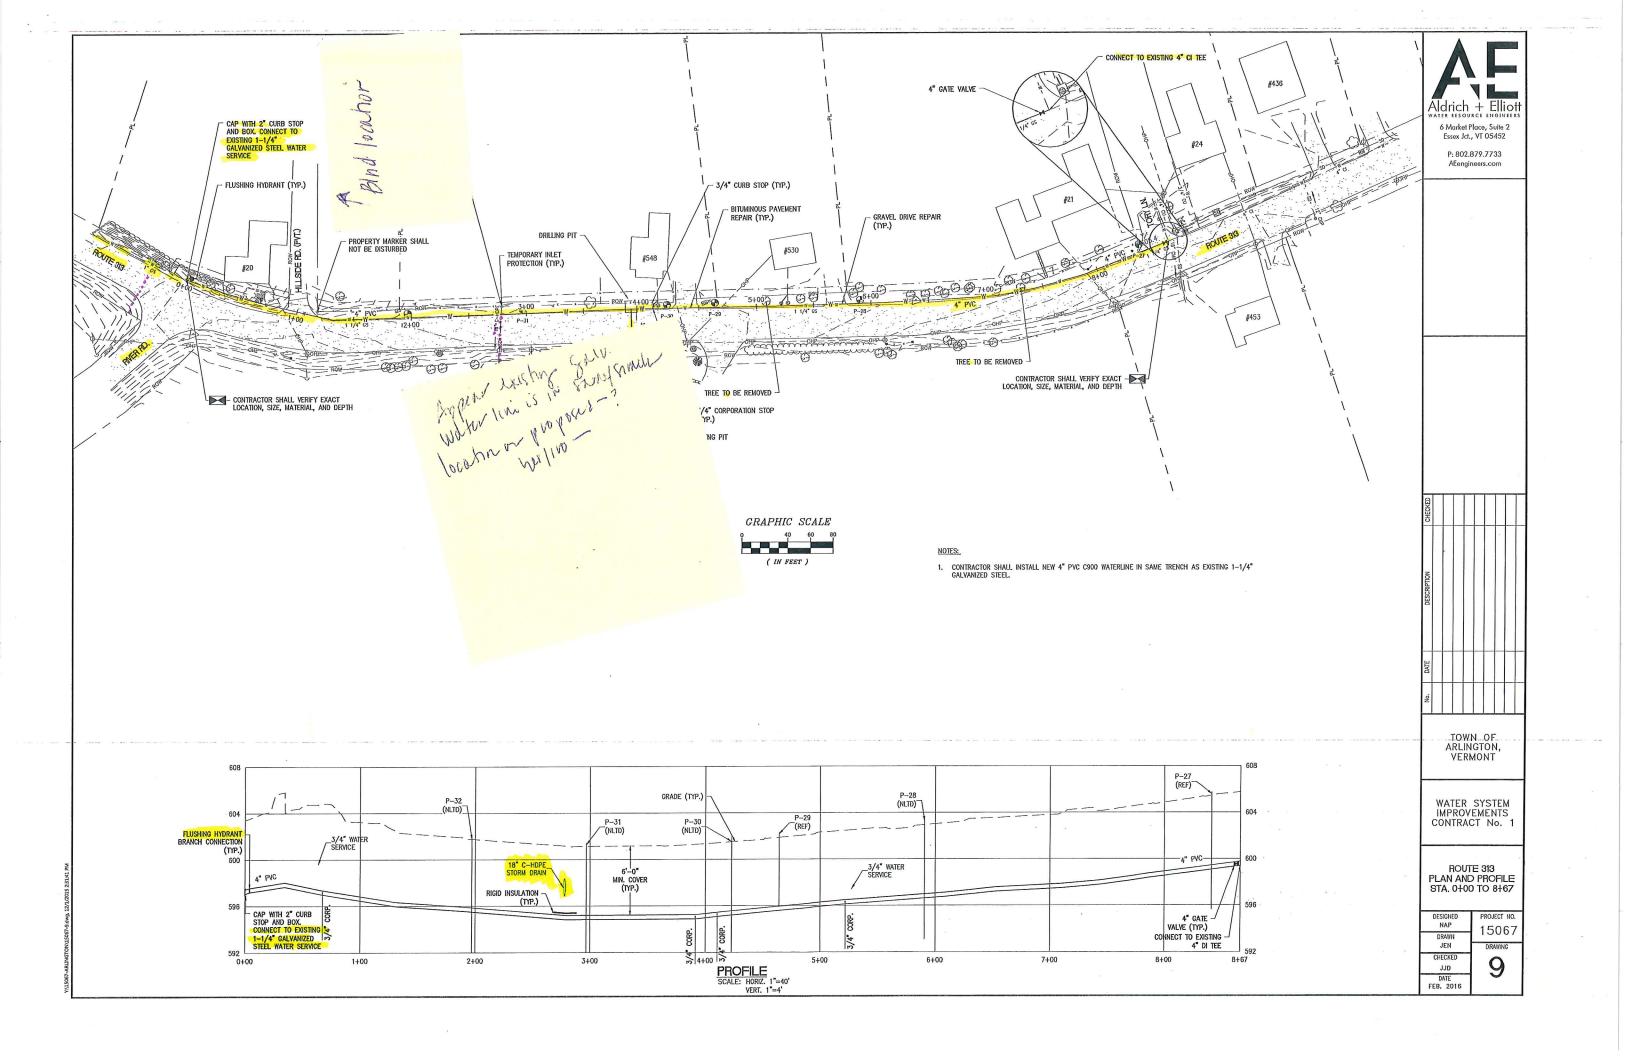


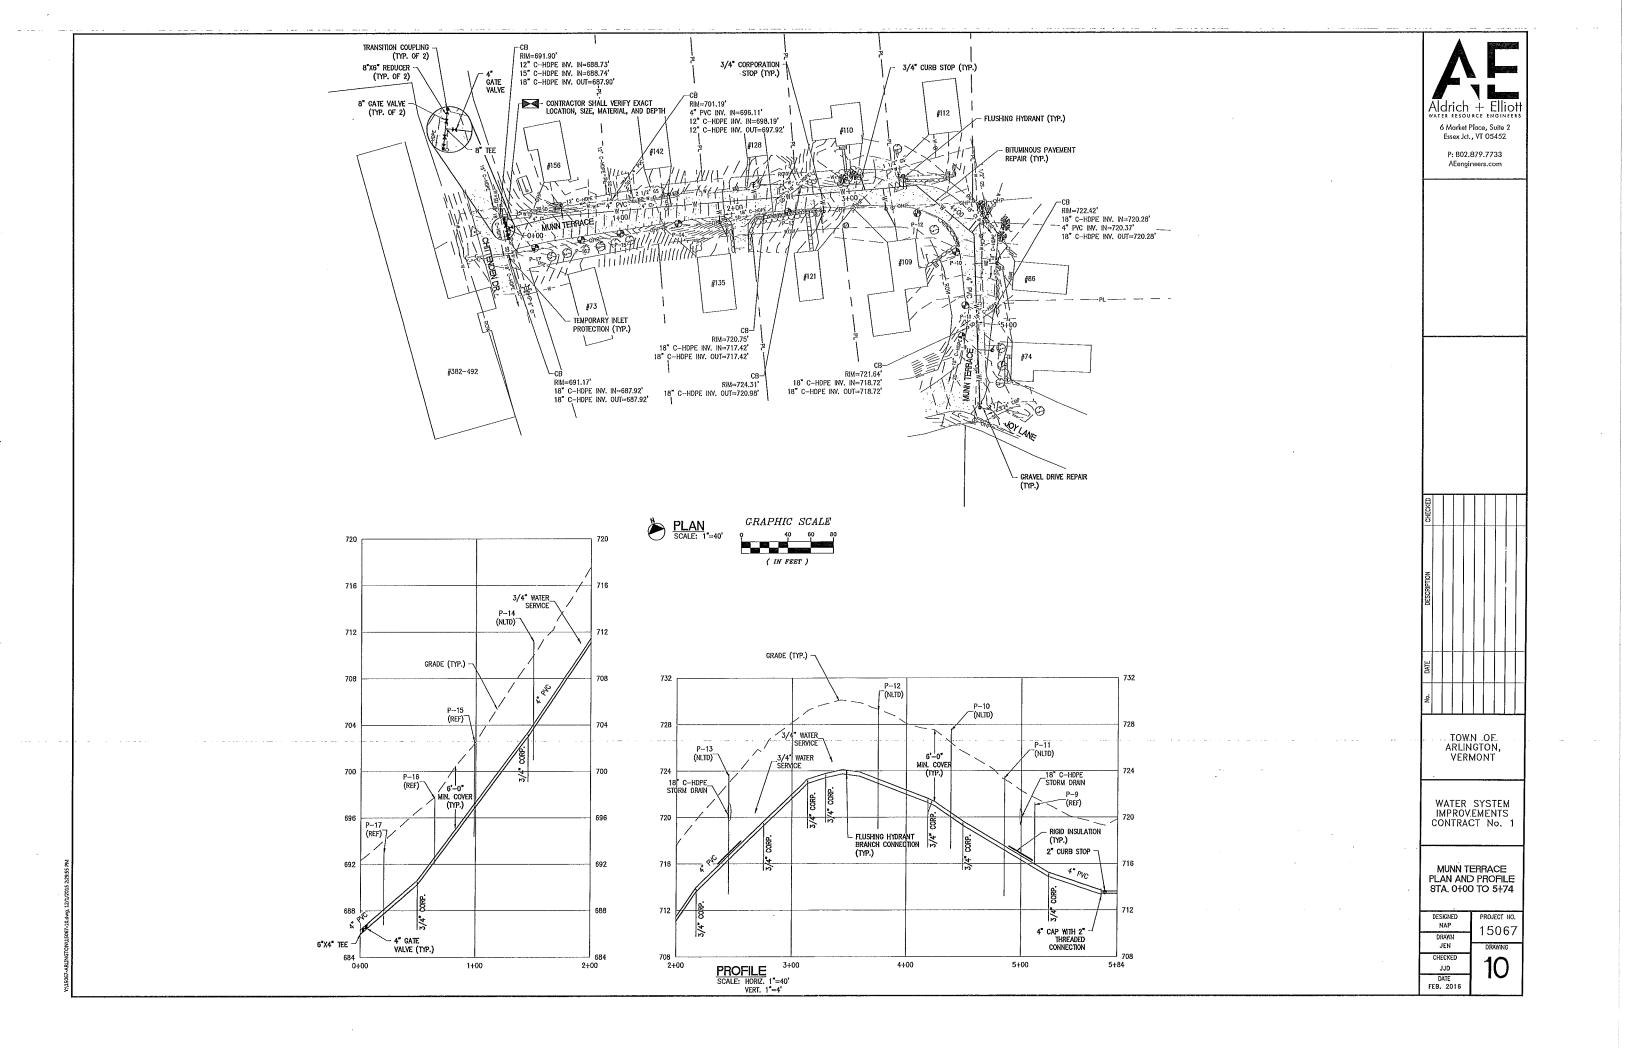


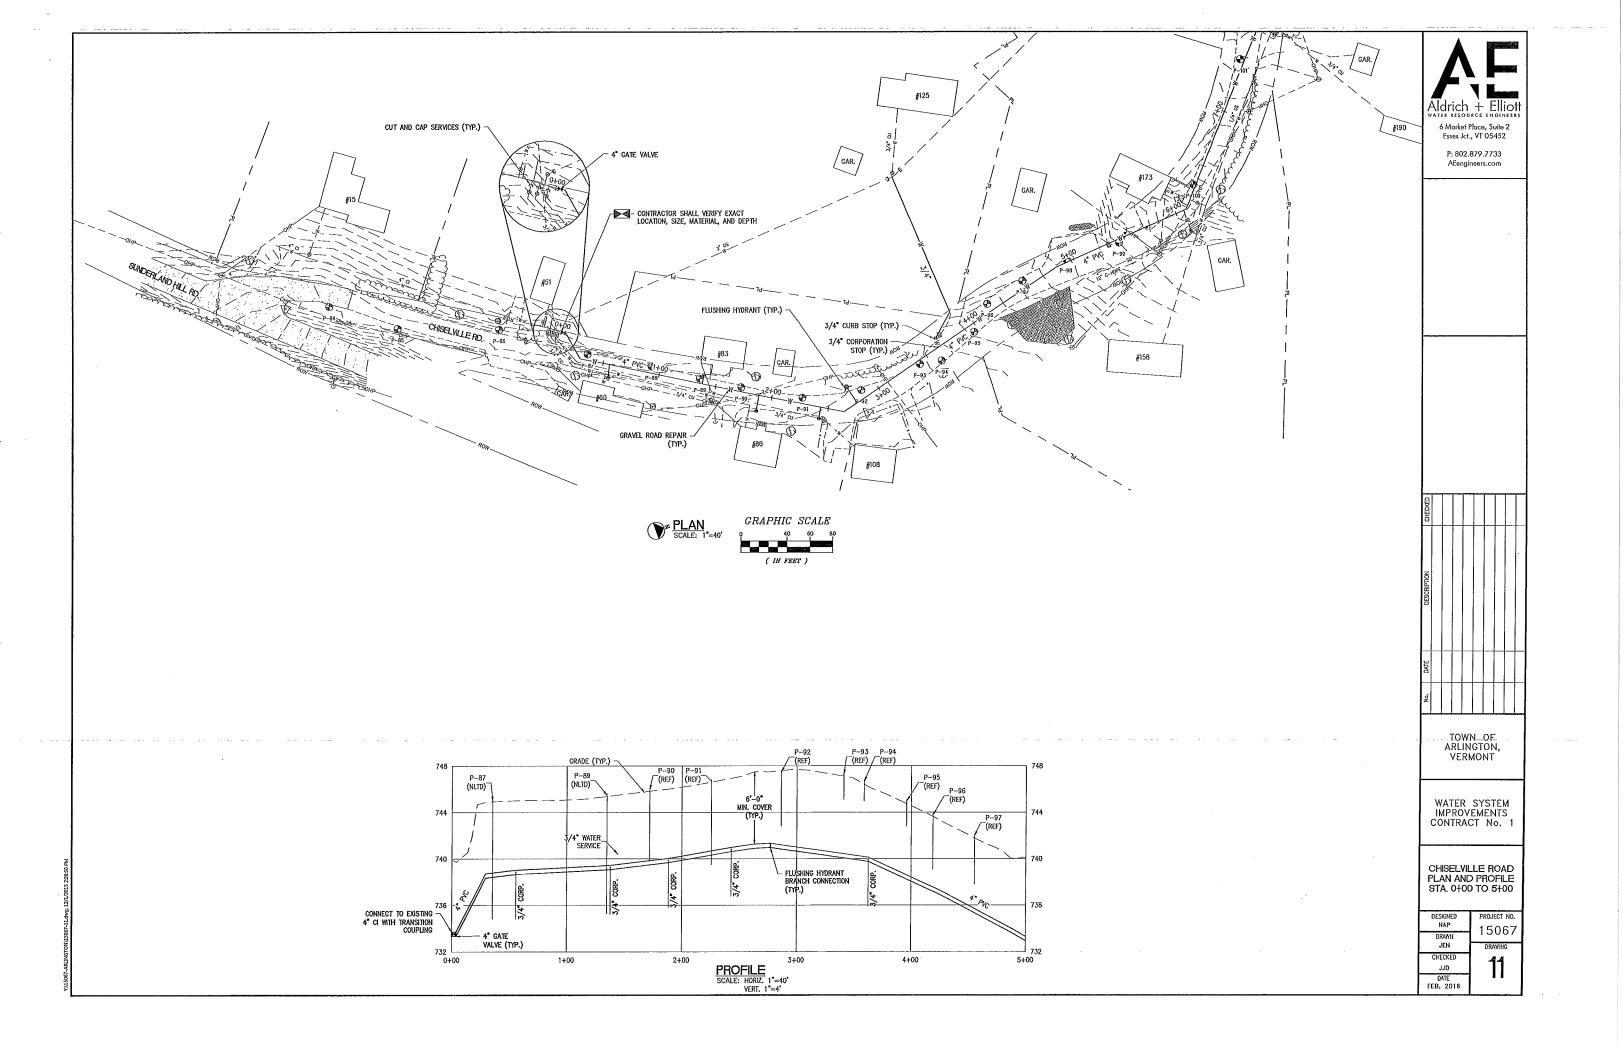

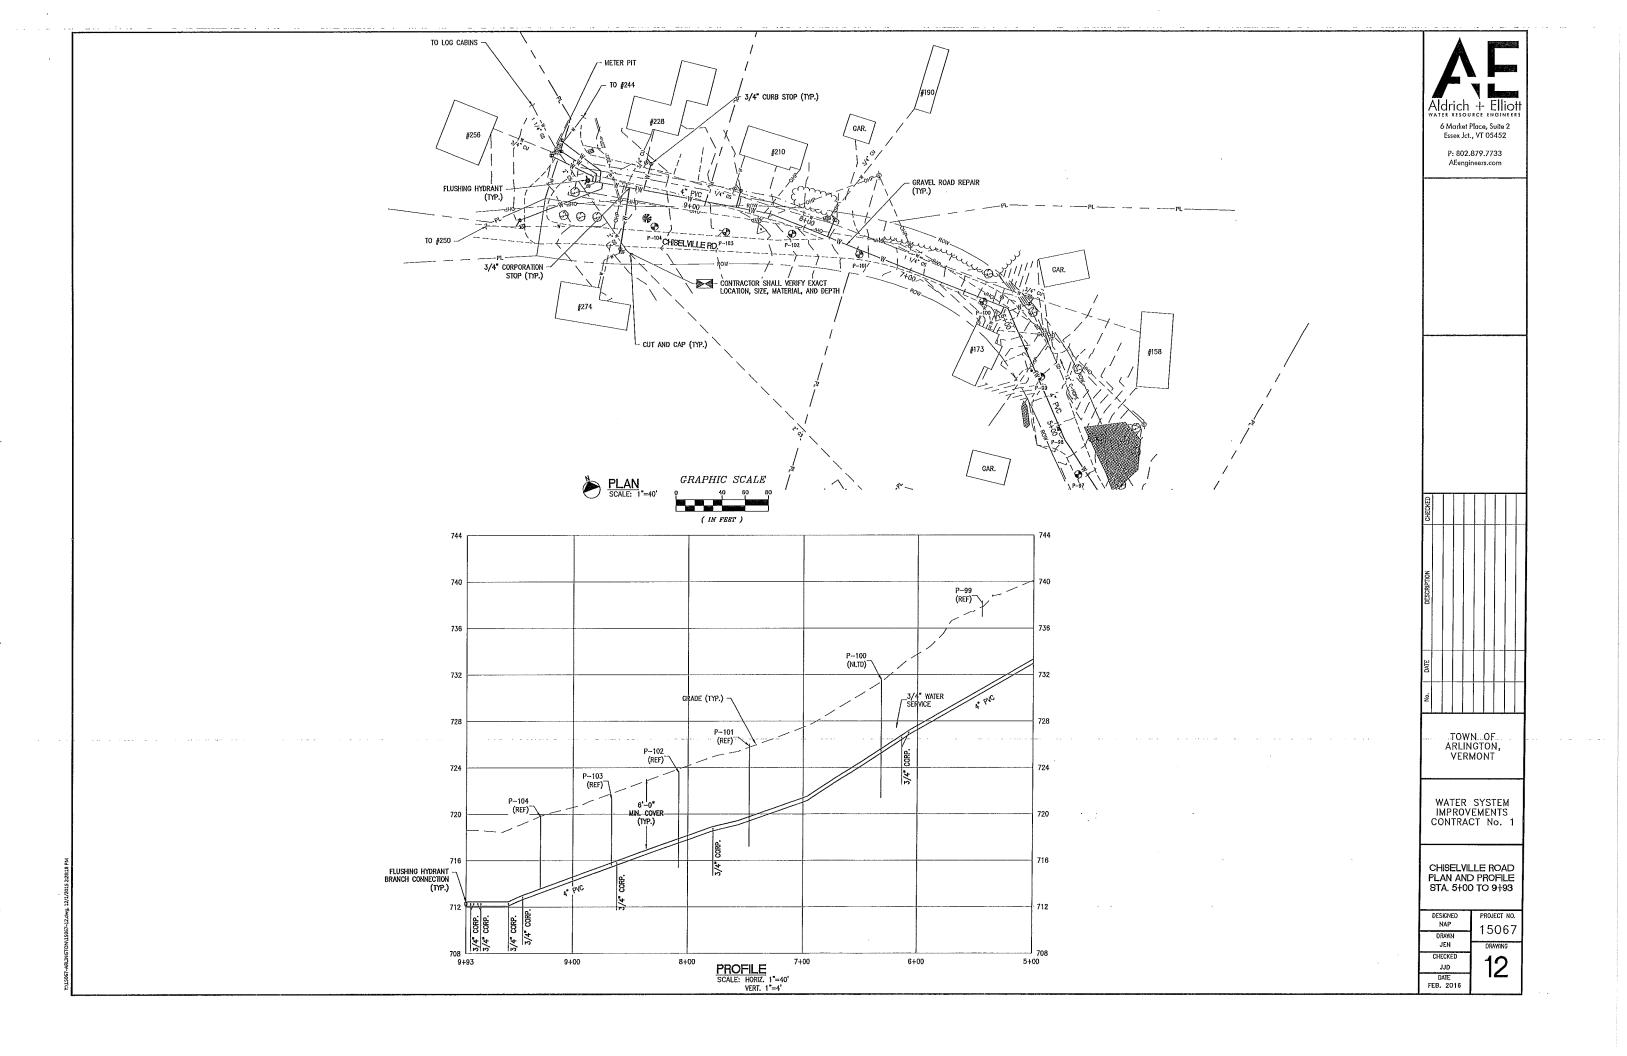

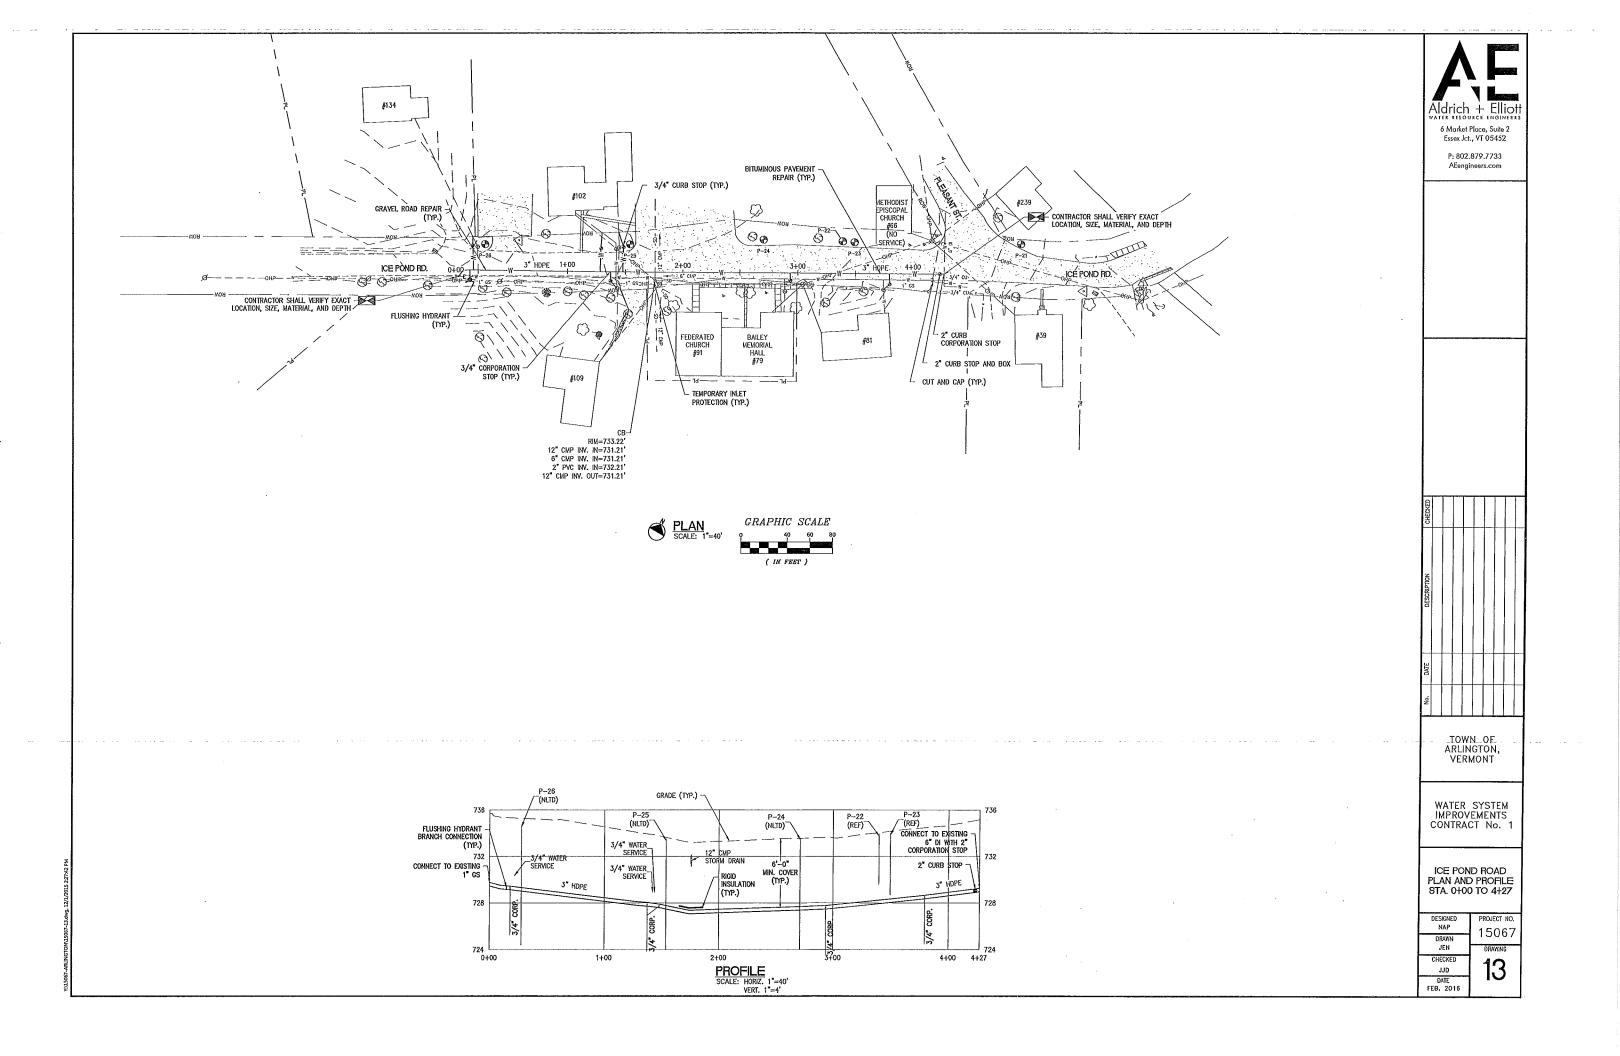

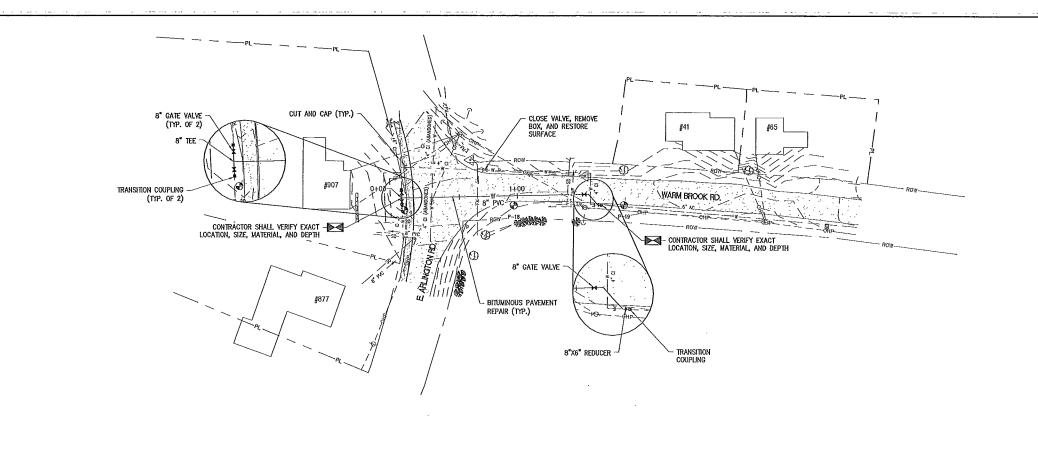

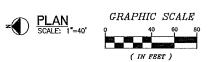

No. DATE DESCRIPTION CHECKED

6 Market Place, Suite 2 Essex Jct., VT 05452

P: 802.879.7733 AEengineers.com


TOWN OF ARLINGTON, VERMONT


WATER SYSTEM IMPROVEMENTS CONTRACT No. 1


WARM BROOK ROAD PLAN AND PROFILE STA. 0+00 TO 1+77

	DESIGNED	PROJECT NO.
	NAP	15067
	DRAWN	13007
	JEN	DRAWING
ĺ	CHECKED	ايميدا
	JJD	1 74 1
	DATE	1-1
	FEB. 2016	

P--20 (NLTD) P-18 / (NLTD) GRADE (TYP.) -736 6'-0" Min. Cover (Typ.) 12" CMP STORM DRAIN 732 4" CI_ \ WATER RIGD — NSULATION (TYP.) - CONNECT TO EXISTING
6" AC WITH
TRANSITION COUPLING 8"X6" TEE -8" PVC 728 8"GATE VALVE 8"X6" REDUCER -724 L 0+00 724 1+77 1+00 PROFILE
SCALE: HORIZ. 1"=40'
VERT. 1"=4'

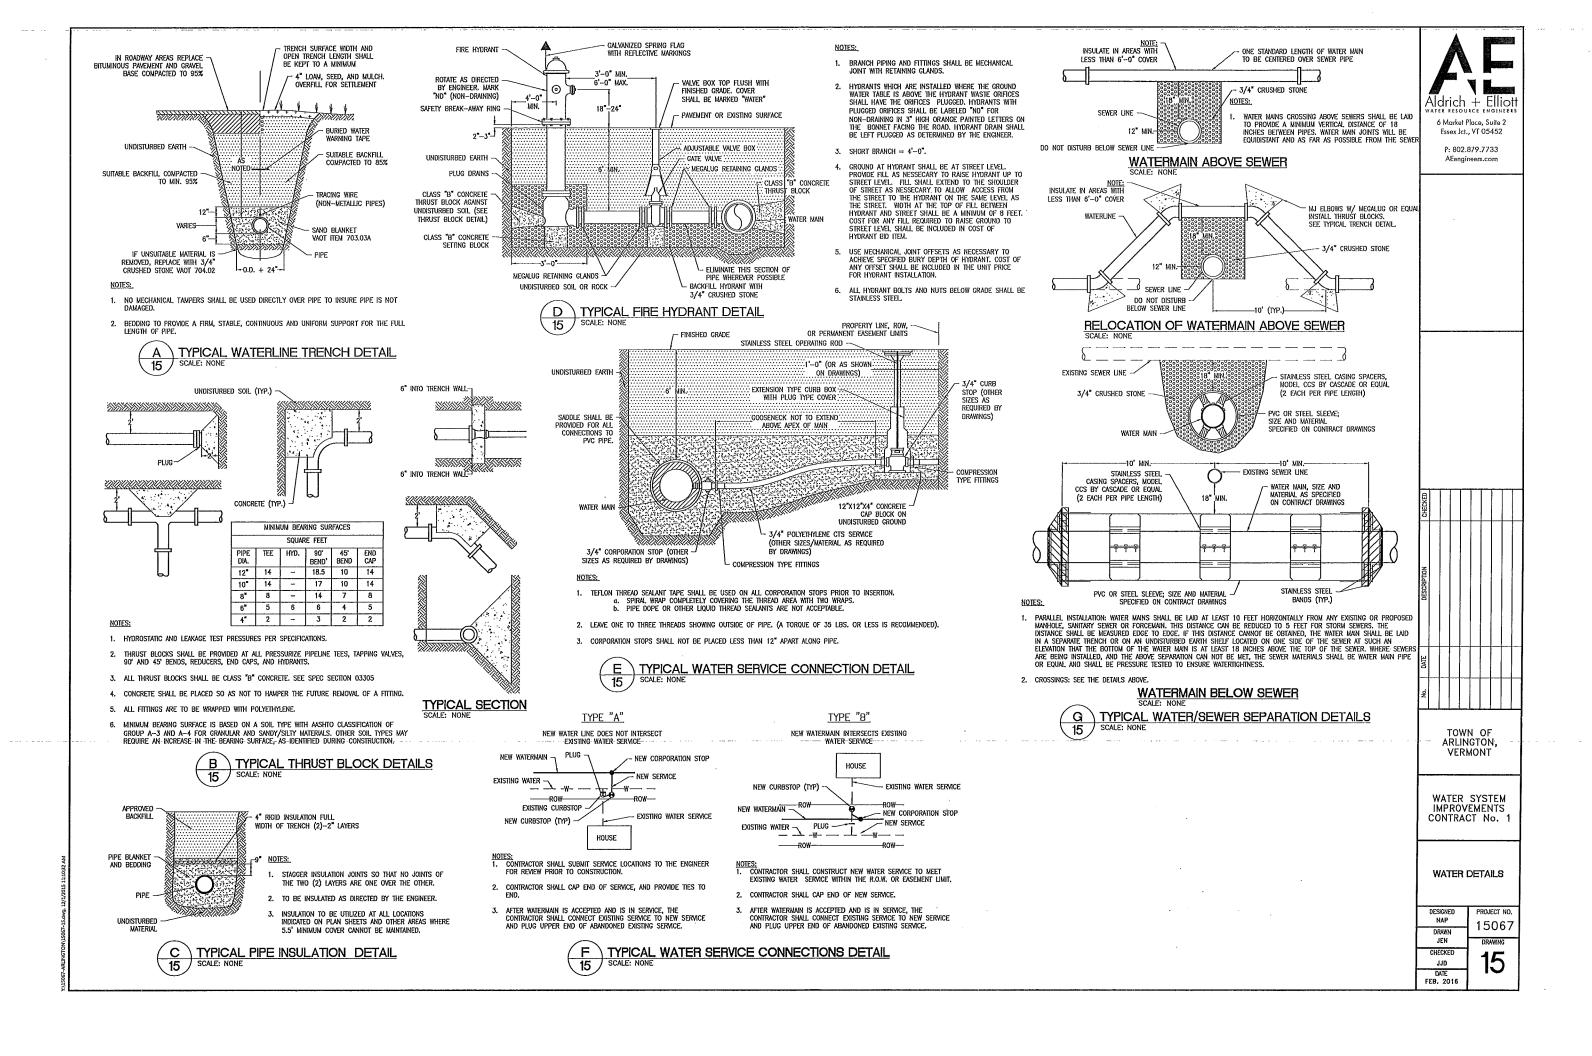

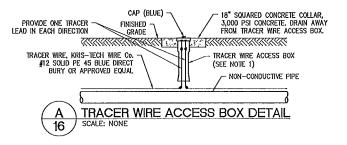

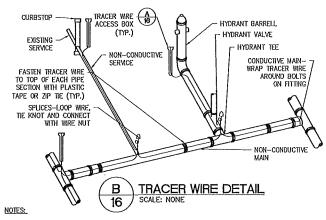


- TRACER WIRE SHALL BE TERMINATED AT EACH END IN A FLUSH MOUNT ACCESS BOX. ACCESS BOX SHALL HAVE A CAST IRON LID THAT CAN BE LOCKED AND OPENED WITH A STANDARD PENTAGON HEAD KEY WRENCH. TRACER WIRES SHALL BE STRIPPED AND ATTACHED TO STAINLESS STEEL READ RET MINIOR. TRACER MIRES STARLE BE STAFFED WITH ATTACHED TO STANLESS STEEL.

 SCREWS MOUNTED TO THE UNDERSIDE OF THE UD. SUFFICIENT SLACK (12" MIN.) SHALL BE LEFT IN

 WIRE LENGTH SO COVER CAN BE LIFTED WITH WIRE INTACT. TRACER WIRE ACCESS BOX SHALL BE


 LOCATED OVER PIPE LINE TO WHICH TRACER LEAD IS ATTACHED AND SET TO GRADE. TRACER WIRE

 LOCATED OVER PIPE LINE TO WHICH TRACER LEAD IS ATTACHED AND SET TO GRADE. TRACER WIRE ACCESS BOX SHALL BE VALVOO TWAB OR APPROVED EQUAL.
- 2. TRACER WIRE ACCESS POINTS SHALL IN GENERAL BE NO MORE THAN 500 FEET APART.

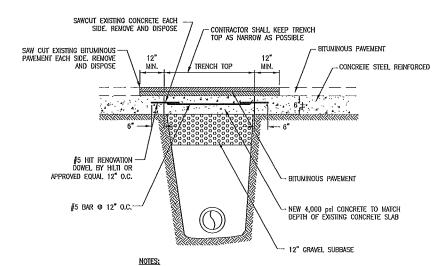

- 1. ALL MATERIALS SHALL HAVE A MINIMUM COMPACTED THICKNESS AS SHOWN IN DETAIL D/15.
- 2. ALL EXISTING ROAD LINES SHALL BE RE-MARKED AS NECESSARY.
- 3. IF NECESSARY, SHOULDER SHALL BE REPLACED TO A CONDITION EQUAL OR BETTER THAN BEFORE CONSTRUCTION ACTIVITIES.



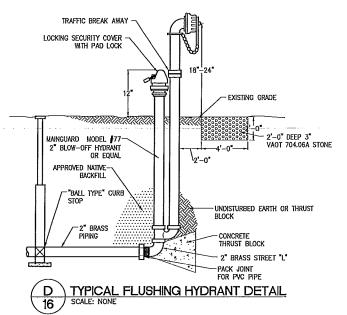

NOTES:

1. POST HYDRANTS SHALL BE POST HTURANIS SHALL BE
NON-DRAINING TYPE WITH A 6'
BURY DEPTH. THESE HYDRANTS
SHALL BE FURNISHED WITH A
HORIZONTAL INLET,—A
NON-TURNING OPERATING ROD, NON-TURRING OPERATING ROD, AND SHALL OPEN TO THE LEFT. ALL OF THE WORKING PARTS SHALL BE OF BRONZE-TO-BRONZE DESIGN, AND BE SERVICEABLE FROM BRONZE AND BE 2-1/2" NST.

6 Market Place, Suite 2 Essex Jct., VT 05452 P: 802.879.7733 AEengineers.com TOWN OF ARLINGTON, VERMONT WATER SYSTEM IMPROVEMENTS CONTRACT No. 1 WATER AND ROADWAY DETAILS PROJECT NO. DESIGNED NAP 15067 JEN


CHECKED 16 JJD DATE FEB. 2016

1. THE TRENCH PAYMENT LIMIT SHALL BE AS FOLLOWS:

DEPTH OF PIPE TRENCH LIMIT 0 TO 10 FEET 0.D.+5' GREATER THAN 10 FEET 0.D.+7'

- 2. THE TRENCH PAYMENT LIMIT SHALL BE THE TRENCH LIMIT AS SHOWN ABOVE.
- 3. THE TRENCH LIMIT APPLIES TO SINGLE PIPE AND DUAL PIPE TRENCHES. NO INCREASE IN TRENCH LIMIT
- 4. THE TRENCH PAYMENT LIMIT APPLIES TO ALL TRENCHES AND ALL SURFACES. SURFACE REPLACEMENT AND RESTORATION OUTSIDE OF THE TRENCH PAYMENT LIMITS WILL BE AT THE CONTRACTOR'S EXPENSE.
- 5. WHERE CONCRETE ROADWAY IS REMOVED PERPENDICULAR TO THE ROADWAY (OR FLOW OF TRAFFIC), THE EDGES OF THE SECTION, TO BE REMOVED WITHIN THE TRENCH PAYMENT LIMITS, SHALL BE SAWCUT STRAIGHT PRIOR TO REMOVAL OF THE CONCRETE.



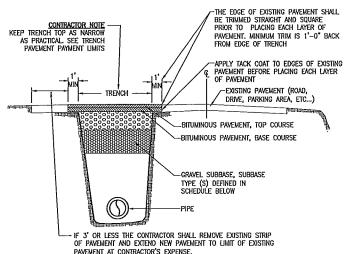

PAVEMENT REPAIR NOTES:

- 1. ALL PAYEMENT SHALL HAVE A MINIMUM COMPACTED THICKNESS AS SHOWN.
- 2, IF NECESSARY, SHOULDER SHALL BE REPLACED TO A CONDITION EQUAL OR BETTER THAN BEFORE
- 3. ALL EXISTING PAVEMENT MARKINGS SHALL BE RE-PAINTED AS NECESSARY.
- 4. IT IS INTENDED THAT CONTRACTOR AVOID ANY DAMAGE TO EXISTING ROADWAY OR SHOULDER PAVEMENT. HOWEVER WHERE PIPE MUST BE INSTALLED WITHIN 3'-0" OF PAVED SURFACE, BITUMINOUS PAVEMENT REPAIR SHALL BE PAID IN ACCORDANCE WITH "TRENCH PAYMENT LIMITS" AND UNIT PRICE BID. PAVEMENT REPAIR OUTSIDE APPROVED LIMITS SHALL BE AT CONTRACTOR'S EXPENSE.

SCHEDULE OF TRENCH REPAIR THICKNESSES

	STREETS	DRIVEWAYS AND PARKING LOTS
BITUMINOUS PAVEMENT		
TOP COURSE	1-1/2" TYPE III	1" TYPE IV
BASE COURSE TYPE II	2-1/2"	2"
FINE GRADED GRAVEL SUBBASE, VAOT ITEM 704.05A	6"	4"
GRAVEL SUBBASE, VAOT ITEM 704.06A	12"	8"


D 17 TRENCH PAVEMENT REPAIR DETAIL

CONTRACTOR NOTE: KEEP TRENCH TOP AS NARROW AS PRACTICAL -THE EOGE OF EXISTING PAYEMENT SHALL BE TRIMMED STRAIGHT AND SQUARE PRIOR TO PLACING EACH LAYER OF (SEE TRENCH PAYMENT LIMITS) PAVEMENT, TRIM SHALL BE 1' BACK GRAVEL PAVED SURFACE -APPLY TACK COAT TO EDGES OF EXISTING PAVEMENT BEFORE PLACING EACH LAYER OF PAVEMENT. - EXISTING PAVEMENT (ROAD. DRIVE, PARKING AREA, ETC...) ____ BITUMINOUS PAVEMENT. TOP COURSE A" FINE CRUSHED GRAVEL --BITUMINOUS PAVEMENT, GRAVEL SUBBASE, SUBBASE TYPE(S) DEFINED IN SCHEDULE OF DETAIL D/17

NOTES:

- 1. IT IS INTENDED THAT THE CONTRACTOR AVOID ANY DAMAGE TO EXISTING ROADWAY OR SHOULDER PAVEMENT. HOWEVER WHERE PIPE MUST BE INSTALLED WITHIN PAVED SURFACE, BITUMINOUS PAVEMENT REPAIR SHALL BE PAID IN ACCORDANCE WITH "TRENCH PAYMENT LIMITS" AND UNIT PRICE BID. PAVEMENT REPAIR OUTSIDE APPROVED LIMITS SHALL BE AT CONTRACTOR'S EXPENSE.
- 2, ALL PAVEMENT AND GRAVEL SUBBASE SHALL HAVE A MINIMUM COMPACTED THICKNESS AS SHOWN IN "SCHEDULE OF TRENCH REPAIR THICKNESSES" SEE DETAIL D/17.
- 3. SEE SPECIFICATIONS FOR FURTHER INFORMATION.
- 4. ALL EXISTING PAVEMENT MARKINGS SHALL BE RE-PAINTED AS NECESSARY.
- 5. IF NECESSARY, SHOULDER SHALL BE REPLACED TO A CONDITION EQUAL TO OR BETTER THAN BEFORE CONSTRUCTION ACTIVITIES.




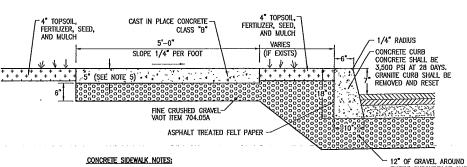


1. PLACE A TOOLED JOINT 1/8" WIDE AND AT LEAST 1/3 OF THE DEPTH @ 5'-0" O.C.

- 2. PLACE AN EXPANSION JOINT EVERY 20'-0" FOR SIDEWALK AND CURBS.
- 3. BROOM FINISH WITH SMOOTH TROWEL EDGES.
- 4. SIDEWALK SHALL BE CONSTRUCTED IN ACCORDANCE WITH VAOT STANDARDS, SECTION 618.
- 5. CONCRETE SHALL BE THICKENED TO 8" THROUGH ALL RESIDENTIAL AND COMMERCIAL DRIVES.
- 6. WHERE ONLY SMALL SECTIONS OF CONCRETE SIDEWALK ARE BEING REPLACED. LE., A SERVICE CROSSING OR HYDRANT INSTALLATION, THE WIDTH SHALL MATCH THE EXISTING SIDEWALK, REFER TO DRAWINGS.
- SIDEWALK AND CURB REPLACEMENT AT SERVICE CROSSINGS AND HYDRANT INSTALLATIONS SHALL BE PAID IN ACCORDANCE WITH THE TRENCH PAYMENT LIMIT DETAIL.
- 8. SIDEWALK AND CURB DISTURBED DURING PIPE INSTALLATION THAT LIES WITHIN THE TRENCH PAYNENT LIMIT PER THE TRENCH PAYMENT LIMIT DETAIL SHALL BE REPLACED PER THIS DETAIL ALL SIDEWALK AND CURB DISTURBED BY THE CONTRACTOR OUTSIDE OF THIS LIMIT WILL BE REPLACED PER THIS DETAIL AT THE CONTRACTOR'S EXPENSE.



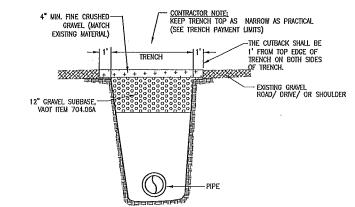

TYPICAL GRAVEL ROAD/DRIVE/OR SHOULDER REPAIR 17

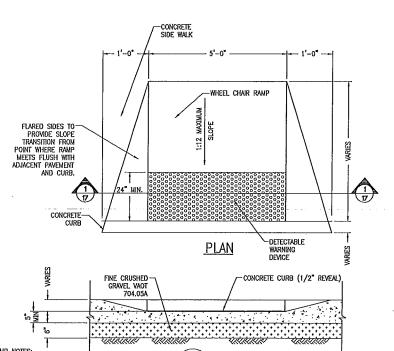

HANDICAP RAMP NOTES: REFER TO TYPICAL SIDEWALK DETAIL FOR ADDITIONAL CONSTRUCTION SPECIFICATIONS. 17

2. RAMP CONCRETE TO HAVE BROOM FINISH.

F SIDEWALK HANDICAP RAMP/CURB CUT/DETECTABLE WARNING DETAIL 17 SCALE: NONE

Aldrich + Elliott 6 Market Place, Suite 2

Essex Jct., VT 05452

P: 802.879.7733 AEengineers.com


TOWN OF ARLINGTON. VERMONT

WATER SYSTEM IMPROVEMENTS CONTRACT No.

ROADWAY DETAILS

DESIGNED PROJECT NO. 15067 DRAW JEN CHECKEE JJD


FEB. 2016

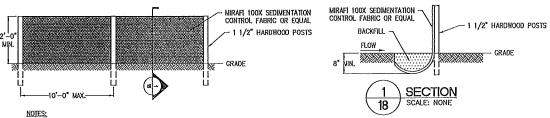

NOTES: 1. SILT FENCE SHALL BE PRE-FABRICATED EROSION CONTROL FENCE BY MIRAFI OR APPROVED EQUAL


- 2. INSTALL WHERE SHOWN ON PLANS. THE FENCE SHALL BE INSTALLED PARALLEL TO CONTOURS WHERE POSSIBLE. THE ENDS OF THE FENCE SHOULD BE CURVED UPHILL TO PREVENT FLOW AROUND THE ENDS.
- 3. SECTIONS OF THE SILT FENCE SHALL BE JOINED TO OVERLAP BY FOLDING FABRIC AROUND EACH POST ONE FULL, TURN, DRIVE POSTS TIGHTLY TOGETHER AND SECURE TOPS OF POSTS BY TYING OFF WITH CORD OR WIRE TO PREVENT FLOW-THROUGH OR BUILT-UP SEDIMENT AT JOINT.
- 4. INSPECT ALL SILT FENCE AT LEAST ONCE A WEEK AND WITHIN 24 HOURS AFTER EACH RAINFALL, MAINTENANCE SHALL BE PERFORMED AS NEEDED, AND SEDIMENT REMOVED WHEN SEDIMENT REACHES 1/3 HEIGHT OF THE SILT FENCE.
- 5. UPON FINAL STABILIZATION OF THE AREA UPHILL OF THE FABRIC, THE FABRIC SHALL BE REMOVED WITH THE APPROVAL OF THE ENGINEER.

A 18 TYPICAL TEMPORARY SILT FENCE DETAIL

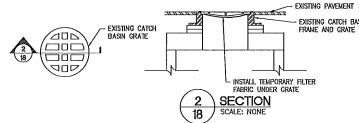

- UNDERGRATE FABRIC INLET PROTECTION SHALL ONLY BE USED WHERE SHOWN ON PLANS. IT SHOULD ONLY BE USED FOR EXISTING CATCH BASINS IN EXISTING PAVED AREAS FOR LINEAR PIPELINE PROJECTS WHERE AMOUNT OF SEDIMENT RUN OFF IS MINIMAL AND DURATION OF CONSTRUCTION IS SHORT.
- 2. LIFT THE GRATE AND INSTALL FILTER FABRIC (MIRAFI 140NL OR EQUAL) OVER THE FRAME, AND THEN SET GRATE
- 3. INSPECT FACH INLET AT LEAST ONCE A WEEK AND WITHIN 24 HOURS AFTER EVERY RAINFALL. REPAIR AND REPLACEMENT OF INLET PROTECTION SHALL BE MADE AT TIME OF INSPECTION
- 4. UPON STABILIZATION OF THE AREA UPSTREAM FROM THE INLET, THE PROTECTION SHALL BE REMOVED WITH THE

\ TYPICAL TEMPORARY INLET PROTECTION DETAIL (18)

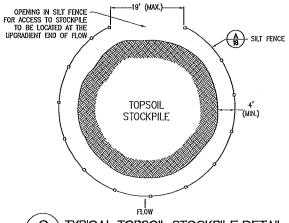

C 18 TYPICAL TOPSOIL STOCKPILE DETAIL

EROSION CONTROL NOTES:

- EROSION CONTROL MEASURES ARE TO BE IMPLEMENTED PRIOR TO PERFORMING ANY EARTHWORK DOWNSTREAM OF THE DISTURBED AREA AND AS DIRECTED BY THE ENGINEER. THE MEASURES SHALL BE MAINTAINED UNTIL THE UPSTREAM DISTURBED AREA HAS BEEN PERMANENTLY STRAILIZED AND AS DIRECTED BY THE ENGINEER. THE CONTRACTOR SHALL TAXILL ALL TEMPORARY EROSION PREVENTION AND SEDIMENT CONTROL MEASURES AS SHOWN ON THE CONTRACT DRAWINGS, THE CONTRACTOR SHALL PROMDE ANY ADDITIONAL MEASURES DEFERMINED MEASURES AS SHOWN ON THE CONTRACT DRAWINGS, THE CONTRACTOR SHALL PROMDE ANY ADDITIONAL MEASURES DETERMINED NECESSARY IN THE FIELD.
- SILT FENCE SHALL BE INSTALLED, AS SHOWN ON THE CONTRACT DRAWINGS PRIOR TO ANY EARTHWORK DOWNSTREAM OF THE DISTURBED AREA AND AS DIRECTED BY THE ENGINEER. THE SILT FENCE SHALL BE MAINTAINED AND CLEANED UNTIL THE UPSTREAM DISTURBED AREA HAS BEEN PERMANENTLY STABILIZED AND AS DIRECTED BY THE ENGINEER. WHERE POSSIBLE NATURAL DRAINAGE WAYS SHALL BE UTILIZED AND LETT OPEN TO REMOVE EXCESS SURFACE WATER.
- 3. PROPER EROSION CONTROLS SHALL BE PROVIDED AROUND STOCKPILED EXCAVATED MATERIALS, THESE CONTROLS MAY INCLUDE, BUT NOT BE LIMITED TO, THE FOLLOWING METHODS OF EROSION PREVENTION AND SEDMENT CONTROL: PERIMETER SILT FENCE; INTERCEPTOR DRAINAGE DITCHES; VELOCITY REDUCTION DAMS IN DRAINAGE DITCHES; TEMPORARY BANK PROTECTION SUCH AS RIPRAP, MATTING, OR ARTIFICIAL COVERING; STONE CHECK DAM CONTROL SYSTEMS; SPECIAL STOCKPILING METHODS; AND WATER BAR
- 4. THE-CONTRACTOR-SHALL-PROVIDE-A MECHANICAL-SWEEPER AND-SHALL-SWEEP CLEAN-THE-ROADS-IN-THE-CONSTRUCTION AREAS AS REQUIRED TO REMOVE ACCUMULATED SEDIMENT AND PREVENT SEDIMENT RUNOFF INTO RECEIVING WATERS AND AS DIRECTED BY THE
- 5. TEMPORARY EROSION CONTROL MEASURES SHALL BE UTILIZED BY THE CONTRACTOR AS REQUIRED TO PREVENT ANY SEDIMENTATION FROM RUNNING INTO RECEMING WATERS. THE CONTRACTOR SHALL MAKE EVERY EFFORT TO MINIMIZE ANY IMPACT OF THE ON-SITE SURFACE RUNOFF ON THE QUALITY OF THE RECEMING WATERS.
- 6. THE SMALLEST PRACTICAL AREA OF LAND SHALL BE DISTURBED AT ANY ONE TIME DURING CONSTRUCTION, WHEN LAND IS DISTURBED DURING CONSTRUCTION, THE DISTURBANCE SHALL BE KEPT TO THE SHORTEST PRACTICAL DURATION AS APPROVED BY THE ENGINEER. LAND SHALL NOT BE LEFT DISTURBED DURING THE WINTER MONTHS AND OVERWINTER STABILIZATION MEASURES SHALL BE INSTALLED
- 7. ALL DISTURBED AREAS AND SIDE SLOPES WHICH ARE FINISH GRADED WITH NO FURTHER CONSTRUCTION TO TAKE PLACE SHALL BE LOAMED, LIMED, FERTILIZED, SEEDED, AND MULCHED WITHIN 48 HOURS OF FINAL GRADING. A MINIMUM OF 3 INCHES OF LOAM SHALL BE PLACED. SEED, LIME, FERTILIZER, AND MULCH SHALL CONFORM TO SPECIFICATION SECTION 02930.
- 8. NO DISTURBED AREAS SHALL BE LEFT UNSEEDED AND UNMULCHED FOR MORE THAN SEVEN (7) DAYS. DISTURBED AREAS WHICH WILL BE REGRADED LATER DURING CONSTRUCTION SHALL BE MULCHED AND SEEDED WITH RYE GRASS TO PREVENT EROSION. HAY OR STRAW MULCH SHALL BE APPLIED TO ALL FRESHLY SEEDED AREAS AT THE RATE OF 2 DYON SPER ACRE. BALES SHALL BE UNSPOILED, AIR DRIED, AND FREE FROM WEED, SEEDS, AND ANY COARSE MATERIAL CONTRACTOR MAY ALSO USE EROSION MATTING OR OTHER APPROVED METHODS OF TEMPORARY COVER.
- 9. ALL EROSION PREVENTION AND SEDIMENT CONTROL STRUCTURES AND MEASURES SHALL BE INSPECTED BY OR UNDER THE DIRECTION OF THE ON-SITE COORDINATOR AT LEAST EVERY SEVEN (7) CALENDAR DAYS AND AS SOON AS POSSIBLE BUT NO LATER THAN 24 HOURS AFTER ANY STORM EVENT WHICH GENERATES A DISCHARGE OF STORMWATER RUNOFF FROM THE CONSTRUCTION SITE.
- 10. AFTER ALL UPSTREAM DISTURBED AREAS HAVE BEEN PERMANENTLY STABILIZED AND AS DIRECTED BY THE ENGINEER, THE DOWNSTREAM TEMPORARY EROSION CONTROL MEASURES ARE TO BE REMOVED AND THE ACCUMULATED SEDMENT PROPERLY DISPOSED OF. THE AREA DISTURBED BY THE REMOVAL OF TEMPORARY MEASURES SHALL BE PREPARED, SEEDED, AND MULCHED.

6 Market Place, Suite 2

Essex Jct., VT 05452


P: 802.879.7733 AEengineers.com


TOWN OF ARLINGTON, VERMONT

WATER SYSTEM **IMPROVEMENTS** CONTRACT No. 1

EROSION CONTROL DETAILS AND NOTES


DESIGNED	PROJECT NO,
NAP	15067
DRAWN	
JEN	DRAWING
CHECKED	40
JJD	ואו
DATE	•
FEB. 2016	l

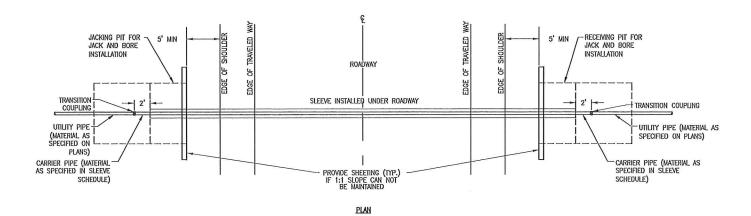

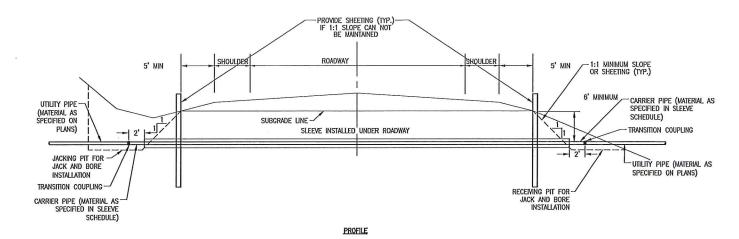



NOTES:
1. CONSTRUCT IN ACCORDANCE WITH VIRANS STANDARD D-20 HIGHWAY CROSSING SLEEVES FOR UNDERGROUND UTILITIES.

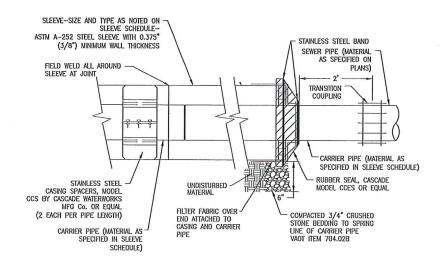

NOTES:

- BID ITEM INCLUDES THE TRANSITION COUPLING AND THE CARRIER PIPE(S) FROM TRANSITION COUPLING TO TRANSITION COUPLING.
- ALL STEEL SLEEVES SHALL BE ASTM A-252 WITH 0.375" (3/8") MINIMUM WALL THICKNESS.
- 3. CARRIER PIPE SHALL BE PUSH-ON WITH FIELD-LOK GASKETS.

SLEEVE SCHEDULE						
Drawing No. Bid Item Location Station Carrier Pipe Size and Type Sieeve Size Installation Me						
C4	A-10	Route 44	0+28 to 0+72	8" DI	24" x 44"	Jack and Bore
C5A	A-10	Route 44	5+68 TO 6+10	8" DI	24" x 42'	Jack and Bore
C7	A-10	Route 44	0+19 to 0+80	8" DI	24" x 61'	Jack and Bore
C7	A-9	Route 44	2+40	6" DI	12" x 40'	Jack and Bore
C7	A-8	Route 44	3+82	4 [™] DI	8" x 44'	Jack and Bore
C7	A-9	Route 44	5+27	6" DI	12" x 44"	Jack and Bore
C7	A-10	Route 44	7+39 to 7+75	8" DI	24" x 36'	Jack and Bore
C9	A-9	Route 44	9+17	6" DI	12" x 28'	Jack and Bore
C9	A-9	Route 44	11+89	6" DI	12" x 28'	Jack and Bore






SINGLE CARRIER PIPE

C TYPICAL SLEEVE SECTION
SCALE: NONE

Adrich + Elliot
WATER RESOURCE ENGINEER
6 Market Place, Suite 2
Essex Jct., VT 05452
P: 802.879.7733
AEengineers.com



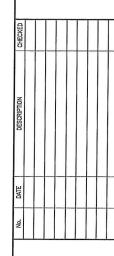

TOWN OF WEST WINDSOR, VERMONT

WEST WINDSOR
BROWNSVILLE
SEWER COLLECTION
SYSTEM
CONTRACT No. 1

SLEEVE SECTIONS
AND
DETAILS

DESIGNED NAP	PROJECT NO.	
DRAWN JEN	14020	
CHECKED	C13	
DATE JUNE, 2015		

Y314020 - West Windsor Brownsulley 14020-C13 dwn 6/30/2015 9-543